

BREAKER CAPACITY (AMPS)	MAX. CIRCUIT LOAD (AMPS)	MAXIMUM LENGTH IN FEET			
		NO.12	NO.10	NO.8	NO.6
20	4	220	349	556	882
	8	110	174	278	441
	12	73	116	185	294
	16	55	87	139	221
30	24	-	58	93	147
	40	-	-	70	110
50	40	-	-	-	88
	60	-	-	-	140
60	48	-	-	-	117

BREAKER CAPACITY (AMPS)	MAX. CIRCUIT LOAD (AMPS)	MAXIMUM LENGTH IN FEET			
		NO.12	NO.10	NO.8	NO.6
20	4	380	605	964	-
	8	190	302	482	765
	12	127	202	321	510
	16	95	151	241	382
30	24	-	101	161	255
	40	-	-	121	191
50	40	-	-	-	153
	60	-	-	-	243
60	48	-	-	-	202

BREAKER CAPACITY (AMPS)	MAX. CIRCUIT LOAD (AMPS)	MAXIMUM LENGTH IN FEET			
		NO.12	NO.10	NO.8	NO.6
20	4	439	698	1113	-
	8	220	349	557	883
	12	127	233	371	589
	16	95	175	278	442
30	24	-	116	186	294
	40	-	-	139	221
50	40	-	-	-	177
	60	-	-	-	281
60	48	-	-	-	234

3-WIRE SYSTEM				4-WIRE SYSTEM			
WIRE TAG	CU/AL	CONDUIT & WIRE	WIRE TAG	CU/AL	CONDUIT & WIRE	WIRE TAG	CU/AL
(20X)	CU	3/4" C. 3#12 + 1#12G.	(20)	CU	3/4" C. 4#12 + 1#12G.	(20X)	CU
(25X)	CU	3/4" C. 3#10 + 1#10G.	(25)	CU	3/4" C. 4#10 + 1#10G.	(25X)	CU
(30X)	CU	3/4" C. 3#10 + 1#10G.	(30)	CU	3/4" C. 4#10 + 1#10G.	(30X)	CU
(35X)	CU	3/4" C. 3#8 + 1#10G.	(35)	CU	3/4" C. 4#8 + 1#10G.	(35X)	CU
(40X)	CU	3/4" C. 3#6 + 1#10G.	(40)	CU	3/4" C. 4#6 + 1#10G.	(40X)	CU
(50X)	CU	1" C. 3#6 + 1#10G.	(50)	CU	1" C. 4#6 + 1#10G.	(50X)	CU
(55X)	CU	3/4" C. 3#6 + 1#10G.	(55)	CU	3/4" C. 4#6 + 1#10G.	(55X)	CU
(60X)	CU	1 1/4" C. 3#4 + 1#10G.	(60)	CU	1 1/4" C. 4#4 + 1#10G.	(60X)	CU
(70X)	CU	1 1/4" C. 3#4 + 1#8G.	(70)	CU	1 1/4" C. 4#4 + 1#8G.	(70X)	CU
(85X)	CU	1 1/4" C. 3#4 + 1#8G.	(85)	CU	1 1/4" C. 4#4 + 1#8G.	(85X)	CU
(100X)	CU	1 1/4" C. 3#2 + 1#8G.	(100)	CU	1 1/4" C. 4#2 + 1#8G.	(100X)	CU
	AL	2" C. 3#1/0 + 1#6G.		AL	2" C. 4#1/0 + 1#6G.		AL
(110X)	CU	1 1/2" C. 3#1 + 1#6G.	(110)	CU	1 1/2" C. 4#1 + 1#6G.	(110X)	CU
	AL	2" C. 3#1/0 + 1#4G.		AL	2" C. 4#1/0 + 1#4G.		AL
(125X)	CU	2" C. 3#1/0 + 1#6G.	(125)	CU	2" C. 4#1/0 + 1#6G.	(125X)	CU
	AL	2" C. 3#2/0 + 1#4G.		AL	2" C. 4#2/0 + 1#4G.		AL
(150X)	CU	2" C. 3#1/0 + 1#6G.	(150)	CU	2" C. 4#1/0 + 1#6G.	(150X)	CU
	AL	2" C. 3#3/0 + 1#4G.		AL	2" C. 4#3/0 + 1#4G.		AL
(175X)	CU	2" C. 3#2/0 + 1#6G.	(175)	CU	2" C. 4#2/0 + 1#6G.	(175X)	CU
	AL	2 1/2" C. 3#4/0 + 1#4G.		AL	2 1/2" C. 4#4/0 + 1#4G.		AL
(200X)	CU	2" C. 3#3/0 + 1#6G.	(200)	CU	2" C. 4#3/0 + 1#6G.	(200X)	CU
	AL	3" C. 3#250KCMIL + 1#4G.		AL	3" C. 4#250KCMIL + 1#4G.		AL
(225X)	CU	2 1/2" C. 3#4/0 + 1#4G.	(225)	CU	2 1/2" C. 4#4/0 + 1#4G.	(225X)	CU
	AL	3" C. 3#300KCMIL + 1#2G.		AL	3" C. 4#300KCMIL + 1#2G.		AL
(250X)	CU	3" C. 3#350KCMIL + 1#2G.	(250)	CU	3" C. 4#350KCMIL + 1#2G.	(250X)	CU
	AL	3" C. 3#350KCMIL + 1#2G.		AL	3" C. 4#350KCMIL + 1#2G.		AL
(300X)	CU	3" C. 3#350KCMIL + 1#4G.	(300)	CU	3" C. 4#350KCMIL + 1#4G.	(300X)	CU
	AL	4" C. 3#500KCMIL + 1#2G.		AL	4" C. 4#500KCMIL + 1#2G.		AL
(350X)	CU	4" C. 3#500KCMIL + 1#3G.	(350)	CU	4" C. 4#500KCMIL + 1#3G.	(350X)	CU
	AL	(2) 2 1/2" C. EA/W 3#4/0 + 1#1G.		AL	(2) 2 1/2" C. EA/W 4#4/0 + 1#1G.		AL
(400X)	CU	4" C. 3#600KCMIL + 1#3G.	(400)	CU	4" C. 4#600KCMIL + 1#3G.	(400X)	CU
	AL	(2) 3" C. EA/W 3#250KCMIL + 1#1G.		AL	(2) 3" C. EA/W 4#250KCMIL + 1#1G.		AL
(450X)	CU	(2) 2 1/2" C. EA/W 3#4/0 + 1#1G.	(450)	CU	(2) 2 1/2" C. EA/W 4#4/0 + 1#1G.	(450X)	CU
	AL	(2) 3" C. EA/W 3#300KCMIL + 1#1/0G.		AL	(2) 3" C. EA/W 4#300KCMIL + 1#1/0G.		AL
(500X)	CU	(2) 3" C. EA/W 3#250KCMIL + 1#2G.	(500)	CU	(2) 3" C. EA/W 4#250KCMIL + 1#2G.	(500X)	CU
	AL	(2) 3" C. EA/W 3#350KCMIL + 1#1/0G.		AL	(2) 3" C. EA/W 4#350KCMIL + 1#1/0G.		AL
(600X)	CU	(2) 4" C. EA/W 3#500KCMIL + 1#2/0G.	(600)	CU	(2) 4" C. EA/W 4#500KCMIL + 1#2/0G.	(600X)	CU
	AL	(2) 4" C. EA/W 3#500KCMIL + 1#2/0G.		AL	(2) 4" C. EA/W 4#500KCMIL + 1#2/0G.		AL
(700X)	CU	(3) 4" C. EA/W 3#500KCMIL + 1#3/0G.	(700)	CU	(3) 4" C. EA/W 4#500KCMIL + 1#3/0G.	(700X)	CU
	AL	(2) 4" C. EA/W 3#600KCMIL + 1#1/0G.		AL	(2) 4" C. EA/W 4#600KCMIL + 1#1/0G.		AL
(800X)	CU	(3) 4" C. EA/W 3#600KCMIL + 1#3/0G.	(800)	CU	(3) 4" C. EA/W 4#600KCMIL + 1#3/0G.	(800X)	CU
	AL	(3) 4" C. EA/W 3#400KCMIL + 1#2/0G.		AL	(3) 4" C. EA/W 4#400KCMIL + 1#2/0G.		AL
(1000X)	CU	(3) 4" C. EA/W 3#600KCMIL + 1#4/0G.	(1000)	CU	(3) 4" C. EA/W 4#600KCMIL + 1#4/0G.	(1000X)	CU
	AL	(3) 4" C. EA/W 3#600KCMIL + 1#4/0G.		AL	(3) 4" C. EA/W 4#600KCMIL + 1#4/0G.		AL
(3000X)	CU	(8) 5" C. EA/W 3#750KCMIL + 1#600KCMIL G.	(3000)	CU	(8) 5" C. EA/W 4#750KCMIL + 1#600KCMIL G.	(3000X)	CU
	AL	(8) 5" C. EA/W 3#750KCMIL + 1#600KCMIL G.		AL	(8) 5" C. EA/W 4#750KCMIL + 1#600KCMIL G.		AL

GENERAL WIRING NOTES:
 1. FOR 2-WIRE SYSTEMS USE Y AS SUFFIX, SIMILAR TO X FOR THE 3-WIRE SYSTEM.
 2. THE USE OF ALUMINUM WIRES HAVE TO BE APPROVED BY THE ENGINEER AND OWNER PRIOR TO BID, NO ALUMINUM WIRES ALLOWED FOR 100A AND LESS.



	TWIN POLE MOUNTED SITE LIGHTING FIXTURE
	SINGLE POLE MOUNTED SITE LIGHTING FIXTURE
	FIXTURE TYPE
	WALL MOUNTED LIGHT FIXTURE
	DOWN LIGHT FIXTURE
	HALF SHADED LIGHTING FIXTURES WIRED TO THE EMERGENCY GENERATOR - TYPICAL FOR ALL HALF SHADED LIGHTING SYMBOLS
	RECESSED LIGHT FIXTURE
	STRIP LIGHT FIXTURE
	EXIT LIGHT FIXTURE - WITH TWIN EMERGENCY HEADS
	EXIT LIGHT FIXTURE - ARROWS AS INDICATED
	REMOTE BATTERY OPERATED EMERGENCY LIGHTING UNIT
	TWIN HEAD BATTERY OPERATED EMERGENCY LIGHTING UNIT
	DUPLEX RECEPTACLE - GROUNDING TYPE
	SPECIAL PURPOSE OUTLET - SIZE AS INDICATED
	DUPLEX RECEPTACLE - W/GFR
	DUPLEX RECEPTACLE - W/GFR ABOVE COUNTER OR AT 42" AFF
	DUPLEX RECEPTACLE - ABOVE COUNTER OR AT 42" AFF
	DOUBLE DUPLEX RECEPTACLE
	DOUBLE DUPLEX RECEPTACLE - ABOVE COUNTER OR AT 42" AFF
	DUPLEX RECEPTACLE CONNECTED TO GENERATOR EMERGENCY POWER
	GFR DUPLEX RECEPTACLE CONNECTED TO GENERATOR EMERGENCY POWER
	SINGLE AND TWO POLE SWITCH
	THREE AND FOUR WAY SWITCH
	KEY SWITCH
	SWITCH WITH PILOT LIGHT
	SWITCH WITH TIMER WITH MIN. 1 HOUR SETTING
	WALL SWITCH DECORATOR SENSOR-PASSIVE DUAL TECHNOLOGY SENSOR SWITCH = WSXA PDT SA WH, OR APPROVED EQUAL
	WALL SWITCH DECORATOR SENSOR-PASSIVE DUAL TECHNOLOGY 2 BUTTON SENSOR SWITCH = WSXA PDT SA 2P WH, OR APPROVED EQUAL
	DIMMING WALL SWITCH DECORATOR SENSOR-PASSIVE DUAL TECHNOLOGY SENSOR SWITCH = WSXA PDT SA WH, OR APPROVED EQUAL
	3 WAY LOW VOLTAGE WALL SWITCH: SINGLE CHANNEL
	3 WAY LOW VOLTAGE DIMMER WALL SWITCH: SINGLE CHANNEL
	nLIGHT = nPDDMA, OR APPROVED EQUAL
	3 WAY LOW VOLTAGE DIMMER WALL SWITCH: TWO CHANNELS
	nLIGHT = nPDDMA 2P DX WH, OR APPROVED EQUAL
	LIGHTING AND/OR RECEPTACLE PANEL
	JUNCTION BOX
	TELEPHONE OUTLET
	TELEPHONE/DATA OUTLET
	DATA OUTLET
	DATA OUTLET - CEILING MOUNTED
	TELEVISION OUTLET 4-SQUARE BOX - SINGLE GANG, 60" AFF EXCEPT AS NOTED; 1" CONDUIT TO BOX FROM ABOVE SUSPENDED CEILING.
	MANUAL MOTOR STARTER (P=PILOT)
	DISCONNECT SWITCH (F=FUSED)
	SIZE 1 COMBINATION MOTOR STARTER
	SINGLE PHASE MOTOR
	THREE PHASE MOTOR
	TRANSFORMER
	CONTACTOR
	TIME SWITCH
	SMOKE DETECTOR
	DUCT MOUNTED SMOKE DETECTOR
	CARBON MONOXIDE DETECTOR
	CARBON MONOXIDE/SMOKE DETECTOR
	FIRE ALARM PULL STATION
	FIRE ALARM HORN/STROBE
	FIRE ALARM STROBE
	FIRE ALARM HORN/STROBE - CEILING OR PENDANT MOUNTED
	FIRE ALARM CONTROL PANEL - FLUSH
	FIRE ALARM ANUNCIATOR PANEL - FLUSH
	OCCUPANCY SENSOR MULTI-TECHNOLOGY CEILING MOUNTED
	OCCUPANCY SENSOR MULTI-TECHNOLOGY WALL MOUNTED WITH LIGHT SWITCH
	OCCUPANCY SENSOR POWER PACK
	PHOTOCELL
	INDICATES 48" ABOVE FINISHED FLOOR
	ABOVE FINISHED GRADE
	ABOVE FINISHED FLOOR
	EXHAUST FAN
	ELECTRICAL TRADES CONTRACTOR
	ELECTRIC WATER COOLER
	GROUND FAULT INTERRUPTER
	NATIONAL ELECTRIC CODE
	MECHANICAL TRADES CONTRACTOR
	PUMP
	SERVICE DISCONNECT
	TIME SWITCH
	WEATHERPROOF

LEGEND NOTES:
 1. ALL OCCUPANCY SENSORS SHALL HAVE ISOLATED AUXILIARY CONTACTS FOR USE BY MECHANICAL TRADES TO CONTROL MECHANICAL EQUIPMENT.
 2. THIS IS STANDARD SYMBOL LIST - SOME OF THESE SYMBOL MAY NOT APPEAR ON DRAWINGS.

SHEET NO.	SHEET TITLE
E0.1	ELECTRICAL COVER SHEET
E0.2	ELECTRICAL SCHEDULES AND DETAILS
E0.3	ELECTRICAL RISER DIAGRAM
E0.4	ELECTRICAL PANELBOARD SCHEDULES
E0.5	ELECTRICAL PANELBOARD SCHEDULES
E1.0	BASEMENT FLOOR PLAN - LIGHTING
E1.1	FIRST FLOOR PLAN - LIGHTING
E1.2	SECOND FLOOR PLAN - LIGHTING
E1.3	THIRD FLOOR PLAN - LIGHTING
E1.4	FOURTH FLOOR PLAN - LIGHTING
E2.0	BASEMENT FLOOR PLAN - POWER
E2.1	FIRST FLOOR PLAN - POWER
E2.2	SECOND FLOOR PLAN - POWER
E2.3	THIRD FLOOR PLAN - POWER
E2.4	FOURTH FLOOR PLAN - POWER
E2.5	ROOF PLAN - POWER
E3.0	ELECTRICAL SITE PLAN

MOUNTING HEIGHTS

EQUIPMENT OR OUTLETS	ELEVATIONS
WALL SWITCHES	4'-0" AFF
RECEPTACLES	1'-6" AFF
TELECOMMUNICATIONS OUTLETS	1'-6" AFF
TELECOMMUNICATIONS OUTLETS - WALL PHONE	4'-6" AFF
CLOCK OUTLETS	4'-6" AFF
TV OUTLETS	1'-6" AFF
FIRE ALARM - PULL STATIONS	4'-0" AFF
FIRE ALARM - SPEAKERS, VISUAL UNITS, HORNS	7'-0" AFF
PUSHBUTTONS	

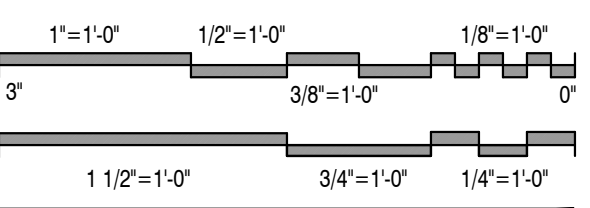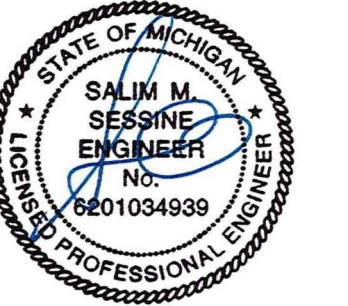

Issued For	Date
Preliminary Review	01.31.2023
Review & Bids	02.27.2023
Bids & Permits	08.12.2024
Plan Review Revisions	03.20.2025
MSHDA Revisions	05.07.2026

Drawing Title

Electrical Riser Diagram

2021-248
Project No. _____
JLW EK
Drawn By _____ Checked By _____
As Noted
Scale



E0.3
Drawing No.

GENERAL RISER NOTES:

- REFER TO SHEET E0.1 FOR ELECTRICAL LEGEND AND E0.2 FOR DETAILS.
- REFER TO SHEETS E0.4 AND E0.5 FOR PANELBOARD SCHEDULES AND LOAD CALCULATIONS.
- REFER TO VOLTAGE DROP SCHEDULE ON SHEET E0.1 AND ADJUST FEEDERS ACCORDINGLY NOT TO EXCEED 2% VOLTAGE DROP FOR FEEDERS AND 3% VOLTAGE DROP FOR BRANCH CIRCUITS.
- RUN ALL UNDERGROUND CONDUITS MIN. 4" UNDER SLAB.
- ALL FLOOR AND GROUND MOUNTED EQUIPMENT (SWITCHBOARDS, DISTRIBUTION PANELS, TRANSFORMERS, POWER PANELS, ETC.) TO BE PAD MOUNTED, PROVIDE CONCRETE PAD AS REQUIRED PER APPROVED EQUIPMENT SUBMITTAL, COORDINATE WITH ARCHITECT.
- COORDINATE WITH UTILITY COMPANY FOR NEW PRIMARY SERVICE REQUIREMENTS, INCLUDING FOR FUTURE EXPANSIONS AND UTILITY UPGRADES.
- COORDINATE WITH MECHANICAL FOR ALL INTERWIRING REQUIREMENTS OF FANS, HOODS, RTU'S, FIRE SUPPRESSION, ETC. PROVIDE AUXILIARY CONTACTS AND/OR CONTACTORS AS DIRECTED.
- EXACT REQUIREMENT FOR ALL EQUIPMENT TO BE VERIFIED, PROVIDE PER APPROVED EQUIPMENT SUBMITTAL AND COORDINATE WITH SUPPLIER FOR EXACT REQUIREMENTS, INFORMATION INDICATED IS FOR REFERENCE ONLY.

RISER KEY NOTES:

- COORDINATE WITH DTE FOR NEW ELECTRICAL SERVICES, EXACT REQUIREMENTS AND SERVICE POINT LOCATION.
- COORDINATE FINAL SELECTION OF ELEVATOR WITH OWNER.
- DUPLEX RECEPTACLE SHALL BE WIRED TO LINE SIDE OF DISCONNECT SWITCH PER N.E.C.
- EXACT REQUIREMENTS FOR FIRE PUMP TO BE PROVIDED PER APPROVED FIRE PUMP SUBMITTALS, INFORMATION INDICATED ON THESE DOCUMENTS ARE FOR REFERENCE ONLY, VERIFY ALL REQUIREMENTS WITH FIRE SUPPRESSION SYSTEM PROVIDER. PROVIDE FIRE PUMP WITH REDUCED VOLTAGE TYPE WYE DELTA CLOSED STARTER, FOR 100HP INDICATED APPROXIMATELY 273.0A FLA AND 529A LRA (33%LRC OF 1603A). PROVIDE 4 SETS OF CONDUCTORS AND SPD DEVICES AS REQUIRED FOR WIRING WYE DELTA MOTOR.
- SERVICE DISCONNECT SD#1 FIRE PUMP NORMAL POWER MAIN DISCONNECT AND EMERGENCY POWER DISCONNECT BOTH PADLOCKED IN THE "ON" POSITION AND SERVICE ENTRANCE RATED WITH N.O. AUXILIARY CONTACTS WIRED TO THE FIRE ALARM SYSTEM FOR REMOTE MONITORING.
- ROUTE FIRE PUMP FEEDER IN CONCRETE ENCASED ENCLOSURE AS A SERVICE PER NEC. MAX 5% VOLTAGE DROP. PROVIDE COPPER CONDUCTORS. SIZING AND RATINGS TYPICAL FROM SOURCE PUMP. PROVIDE ALL CONTROL WIRING, 2 HOUR FIRE RATED, FROM FIRE PUMP CONTROLLER TO GENERATOR AND FIRE ALARM SYSTEM AS REQUIRED, PROVIDE FIRE RATED INSTALLATION.
- PROVIDE PERMANENT PLACARDS ON ALL SERVICE DISCONNECTING MEANS TO IDENTIFY LOCATION PER NEC.
- PROVIDE SURGE PROTECTIVE DEVICE SPD FOR ALL PANELBOARDS CONNECTED DOWNSTREAM OF ATS-1.
- PROVIDE MANUAL TRANSFER SWITCH WITH WITH CAM-LOCK RECEPTACLES, KEY INTERLOCK, REMOTE GENERATOR START/STOP, PHASE ROTATION EQUAL, NEMA 3R, STRIP HEATER WITH THERMOSTAT, ASCO 300 SERIES OR EQUAL TO COMPLY WITH NEC 700.3 (F) AS APPLIES FOR TEMPORARY SOURCE OF POWER FOR MAINTENANCE/REPAIR, PERMANENTLY MARK CONNECTION CABINET WITH PHASE ROTATION AND SYSTEM BONDING REQUIREMENTS AND PROVIDE ANNUNCIATION WHEN THE PERMANENT EMERGENCY GENERATOR IS DISCONNECTED FROM THE EMERGENCY SYSTEM.
- PROVIDE BREAKERS, FEEDERS, DISCONNECTS ETC. FOR MULTIPLE EQUIPMENT, INDICATED ONLY ONE FOR TYPICAL INSTALLATION, TOTAL NUMBER AS NOTED, REFER TO PLANS AND PANEL SCHEDULES AND VERIFY EXACT QUANTITIES.

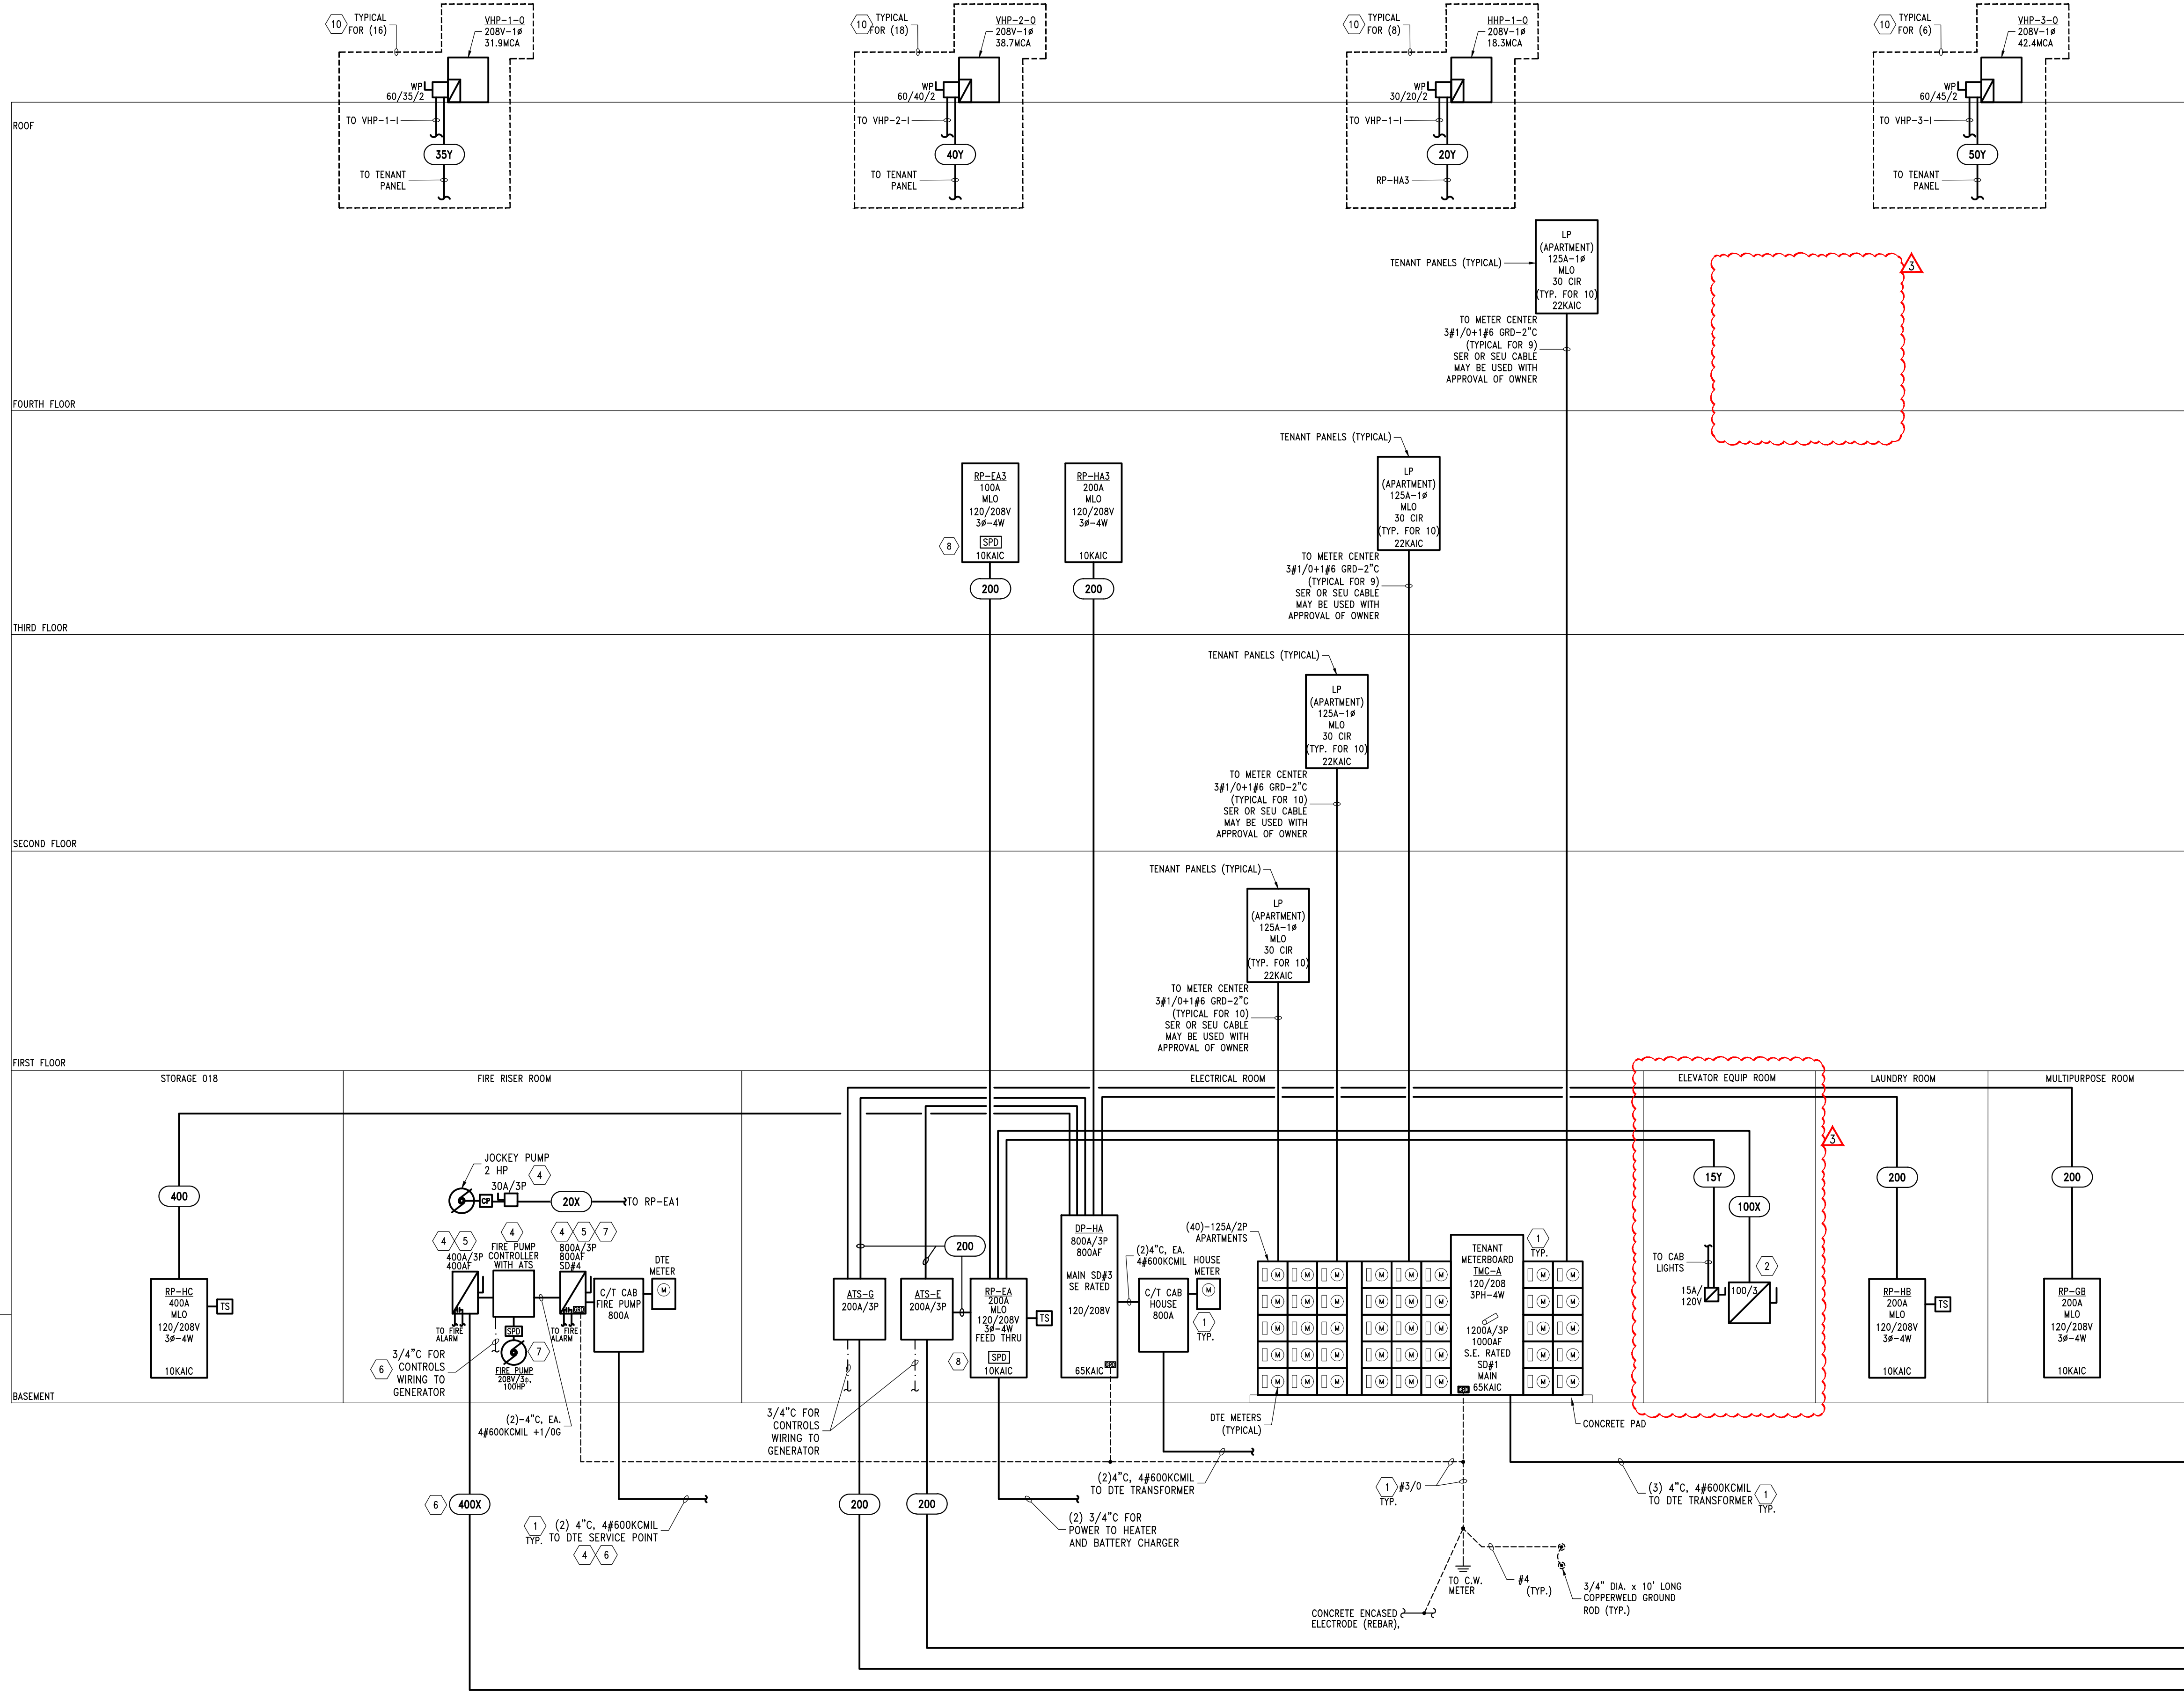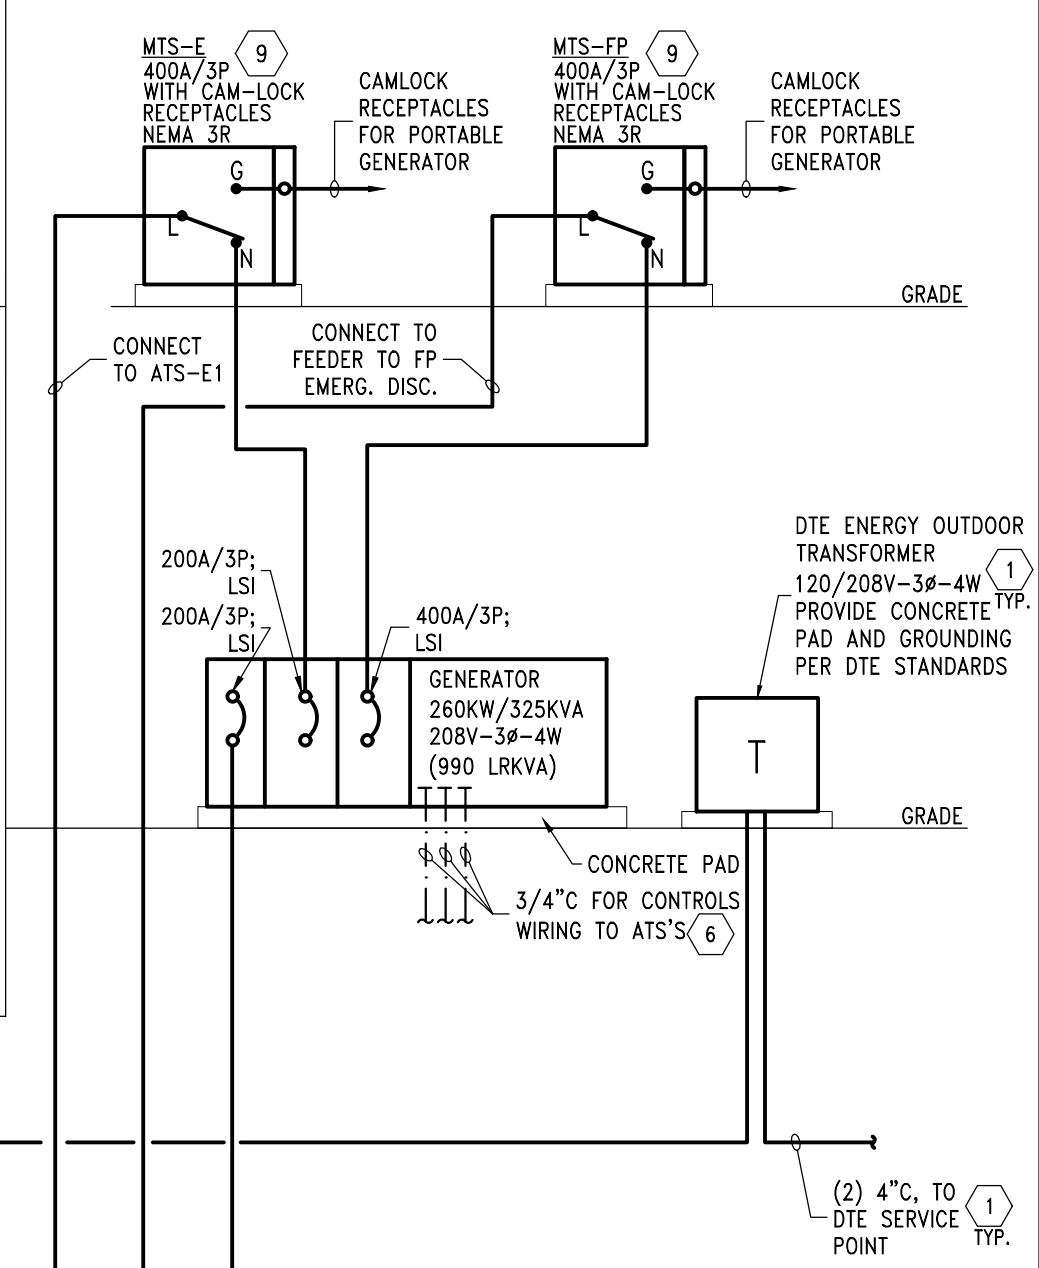

Electrical Riser Diagram
No Scale (120/208V-3Ø-4W)

H:\EAM-MAIN\Projects\2021\483 Shelter Design\21061 Linwood Apartments\CAD\ELEC\E0.3 Electrical Riser.dwg, 6/2/2026 11:58:03 AM, jwatson

APARTMENTS - TOTAL BUILDING		
TOTAL BUILDING		
UNIT TYPE	NO.	CONNECTED LOAD (VA)
1 BED	16	307,840
2 BED	18	383,472
2 BED W/SITTING ROOM	6	134,844
		0
TOTAL UNITS	40	
TOTAL CONN. (VA)		826,156
DEMAND PERCENTAGE %		28
IPER N.E.C. 220.64		
DEMAND (VA)		231,324
DEMAND (AMP)		643
SERVICE SIZE AT 208V 3PH		1,000

APARTMENTS LOAD CALCULATIONS			
	1 BED	2 BED	2 BED W/SITTING
AREA (SQUARE FT.)	567	854	1,026
LIGHTING AT 3VA/SQ. FT.	1,701	2,562	3,078
SMALL APPLIANCE	3,000	3,000	3,000
RANGE	7,700	7,700	7,700
DISH/WASHER	1,200	1,200	1,200
LAUNDRY			
WATER HEATER+GAS DRYER			
HVAC	5,639	6,842	7,496
EV CHARGER			
TOTAL VOLT AMP (VA)	19,240	21,304	22,474
DEMAND LOAD PER NEC220			
AIR CONDITIONING	5,639	6,842	7,496
REMAINING LOAD	13,601	14,462	14,978
FIRST 10,000 VA AT 100%	10,000	10,001	10,002
BALANCE AT 40%	1,440	1,764	1,990
TOTAL VOLT AMP (VA)	17,079	18,627	19,488
DEMAND AMPS AT 208V 1PH	71	90	94
APARTMENT PANEL SIZE AT 208V 1PH(A)	125	125	125

DISTRIBUTION PANEL SCHEDULE DP-HA							
120/208V, 3PH, 4W+G, 800A/3P 800A MCB							
POSITION	CIRCUIT BREAKER	EQUIPMENT	CONNECTED LOAD (KVA)	DEMAND LOAD (KVA)	FEEDER SIZE (COPPER)	FEEDER SIZE (AL)	
1	200A/3P	200 A	ATS-E	38.4	34.6	2" C, 4#3/0 & 1#6 G	
2	200A/3P	200 A	ATS-G	18.9	17.2	2" C, 4#3/0 & 1#6 G	
3	200A/3P	200 A	RP-HB	50.6	41.7	2" C, 4#3/0 & 1#6 G	
4	400A/3P	400 A	RP-HC	45.4	37.8	4" C, 4-600 kcmil & 1#3 G	
5	200A/3P	200 A	RP-HA3	33.3	28.1	2" C, 4#3/0 & 1#6 G	
6	30A/2P	20 A	SPARE				
7	30A/2P	30 A	SPARE				
8	30A/2P	30 A	HHP-3-I / HHP-3-O	20.8 MCA	3.7	2.9	3/4" C, 2#10 & 1#10 G
9	60A/2P	45 A	VHP-3-I / VHP-3-O	42.4 MCA	7.5	6.0	1" C, 2#6 & 1#10 G
10	60A/2P	45 A	VHP-3-I / VHP-3-O	42.4 MCA	7.5	6.0	1" C, 2#6 & 1#10 G
11	30A/3P	20 A	EH-2	4 KW	4.0	3.2	3/4" C, 3#12 & 1#12 G
12	30A/3P	20 A	SP-2	6.4 A	2.3	1.8	3/4" C, 3#12 & 1#12 G
13	60A/3P	35 A	DWBP-1	21.2 FLA	7.6	6.1	3/4" C, 3#8 & 1#10 G
14	100A/3P	-	SPACE				
15	100A/3P	-	SPACE				
16	100A/3P	-	SPACE				
17	100A/2P	-	SPACE				
TOTAL DEMAND LOAD:			219 KVA	188 KVA			
			609 A	516 A			

PROJECT: Linwood Apts		200	MLO	CLASS: 120/208V-3PH-4W+G	RP-EA
PROJ NO: 21061		10 KAIC; FEED THRU		MOUNTING: SURFACE	
BRANCH CIRC.	WATTS	CODE	REMARKS		
NO. POLES BKR.	BUS A	BUS B	BUS C	L	R
1 1 20	900			L	R
3 1 20		1200		L	R
5 1 20			1200	L	R
7 1 20	1400			L	R
9 1 20		1400		L	R
11 1 20			1200	L	R
13 1 20	1200			L	R
15 1 20		600		L	R
17 1 20			400	L	R
19 1 20	400			L	R
21 1 20				L	R
23 1 20				L	R
25 1 20				L	R
27 1 20				L	R
29 1 20				L	R
31 1 20				L	R
33 1 20				L	R
35 1 20				L	R
37				L	R
39 3 50	3504	3504		L	R
41			3504	L	R
2 1 20	635			L	R
4 1 20		1800		L	R
6 1 20			500	L	R
8 1 20	500			L	R
10 1 20		800		L	R
12 1 20			1500	L	R
14 1 20	1500			L	R
16 1 20		1440		L	R
18 1 20			200	L	R
20 1 20				L	R
22 1 20				L	R
24 1 20				L	R
26 1 20				L	R
28 1 20				L	R
30 1 20				L	R
32 1 20				L	R
34 1 20				L	R
36 1 20				L	R
38		940		L	R
40 3 20		940		L	R
42			940	L	R
LIGHTING LOAD	4,135	3,200	2,800		10135 W
RECEPTACLE LOAD	2,000	800	2,000		4800 W
EQUIPMENT LOAD	4,844	7,684	6,144		18672 W
RP-EA3	2,400	1,200	1,200		4800 W
TOTAL LOAD	13,379	12,884	12,144		38407 W
					107 A
					96 A
					CONNECTED LOAD
					DEMAND LOAD
					2 HP ESTIMATED

PROJECT: Linwood Apts		200A	MLO	CLASS: 120/208V-3PH-4W+G	RP-GB
PROJ NO: 21061		10 KAIC		MOUNTING: SURFACE	
BRANCH CIRC.	WATTS	CODE	REMARKS		
NO. POLES BKR.	BUS A	BUS B	BUS C	L	R
1 1 20	1200			L	R
3 1 20		800		L	R
5 1 20			800	L	R
7 1 20	1200			L	R
9 1 20		1200		L	R
11 1 20			1200	L	R
13 1 20	500			L	R
15 1 20		400		L	R
17 1 20			200	L	R
19 1 20	200			L	R
21 1 20				L	R
23 1 20				L	R
25 - - -				L	R
27 - - -				L	R
29 - - -				L	R
31 - - -				L	R
33 - - -				L	R
35 - - -				L	R
37 - - -				L	R
39 - - -				L	R
41 - - -				L	R
2 1 20	875			L	R
4 1 20		1200		L	R
6 1 20			1000	L	R
8 1 20	400			L	R
10 1 20		200		L	R
12 1 20			200	L	R
14 1 20				L	R
16 1 20				L	R
18 1 20				L	R
20 1 20				L	R
22 1 20				L	R
24 1 20				L	R
26 - - -				L	R
28 - - -				L	R
30 - - -				L	R
32				L	R
34 2 30				L	R
36			1838	L	R
38 2 30		1838		L	R
40		1838		L	R
42			1838	L	R
LIGHTING LOAD	1,775	200	200		2175 W
RECEPTACLE LOAD	2,600	2,400	3,200		8200 W
EQUIPMENT LOAD	1,838	3,038	3,676		8552 W
TOTAL LOAD	6,213	5,638	7,076		18927 W
					53 A
					48 A
					CONNECTED LOAD
					DEMAND LOAD

PROJECT: Linwood Apts		200A	MLO	CLASS: 120/208V-3PH-4W+G	RP-HB
PROJ NO: 21061		10 KAIC		MOUNTING: FLUSH	
BRANCH CIRC.	WATTS	CODE	REMARKS		
NO. POLES BKR.	BUS A	BUS B	BUS C	L	R
1 1 20	800			L	R
3 1 20		600		L	R
5 1 20			400	L	R
7 1 20	1200			L	R
9 1 20		1200		L	R
11 1 20			1200	L	R
13 1 20	1200			L	R
15 2 30		2500		L	R
17			2500	L	R
19 2 30	2500			L	R
21		2500		L	R
23 2 30			2500	L	R
25	2500			L	R
27 2 30		2500		L	R
29			2500	L	R
31	1334			L	R
33 3 20		1334		L	R
35			1334	L	R
37	1100			L	R
39 3 20		1100		L	R
41			1100	L	R
43 1				L	R
45 1				L	R
47 1				L	R
49 1				L	R
51 1				L	R
53 1				L	R
2 1 20	600			L	R
4		1667		L	R
6 2 20			1667	L	R
8	1667			L	R
10		1100		L	R
12 2 20			1100	L	R
14	1100			L	R
16 1 20		1800		L	R
18 1 20			1000	L	R
20 1 20	700			L	R
22 1 20		1400		L	R
24 1 20			1200	L	R
26 1 20	225			L	R
28 1 20		1500		L	R
30 1 20				L	R
32 1 20				L	R
34 1 20				L	R
36 1 20				L	R
38 1 20				L	R
40 1 20				L	R
42 1 20				L	R
44 1				L	R
46 1				L	R
48 1				L	R
50 1				L	R
52 1				L	R
54 1				L	R
LIGHTING LOAD	225	400	625 W		625 W
RECEPTACLE LOAD	1,400	2,200	5600 W		5600 W
EQUIPMENT LOAD	13,301	17,201	13,901		44403 W
TOTAL LOAD	14,926	19,201	16,501		50628 W
					141 A
					116 A
					CONNECTED LOAD
					DEMAND LOAD

PROJECT: Linwood Apts		125A	MLO	CLASS: 120/208V-1PH-3W+GRD.	PANEL LP
PROJ NO: 21061		22 KAIC		MOUNTING: FLUSH	(3 BED UNIT

H:\EAM-MAIN\Projects\2021\483 Shelter Design\21061 Linwood Apts\CAD\ELEC\ED4-ED5 Electrical Panel Schedules.dwg, 6/2/2026 11:55:46 AM, jwatson


PROJECT: Linwood Apts				400A	MLO	CLASS: 120/208V-3PH-4W+G		RP-HC	
PROJ NO: 21061				10 KAIC		MOUNTING: SURFACE			
BRANCH CIRC.	POLES	BKR.	WATTS	BUS A	BUS B	BUS C	CODE	REMARKS	
NO.							L R E		
1	1	20	1700				L		Lighting Basement Storage
3	1	20	1000				R		Receptacles Basement Storage
5	1	20				800	R		Receptacles Exterior
7	1	20							Receptacles Basement
9			1334						
11	2	20				1334			EUH-3
13			1334						
15			1334						
17	2	20				1334			EUH-3
19			1334						
21			1100						
23	2	20				1100			EUH-1
25			1100						
27			1334						
29	3	20				1334			EUH-3
31			1334						
33	1	20				1500			EH-1 1st Flr Stair 111
35	1	20				800			CP-1 Basement Storage 015
37			1333						
39	3	20				1333			EH-2 1st Flr Stair 112
41						1333			
43	1	20							spare
45	1	20							spare
47	1	20							spare
49	1								SPACE
51	1								SPACE
53	1								SPACE
2	1	20	600						DWH-1
4	1	20				600			DWH-2
6	1	20				600			DWH-3
8	1	20	1500						EH-1 1st Flr Gate Entry 114
10						1334			
12	3	20				1334			EUH-3
14			1334						
16			3024						
18	3	35				3024			DOAS-1
20			3024						
22	2	15							SPARE
24									
26	2	15							SPARE
28									
30	2	15							SPARE
32									
34	1	20				1600	R		Receptacles 1st Flr Corr/Mech
36	1	20				1600	R		Receptacles 2nd Flr Corr/Mech
38	1	20	350				L		Lighting 1st & 2nd Flr Mech
40	1	20				400	R		Receptacles 1st Flr Corr
42	1	20							spare
44	1	20							spare
46	1								SPACE
48	1								SPACE
50	1								SPACE
52	1								SPACE
54	1								SPACE
LIGHTING LOAD			2,050						2050 W
RECEPTACLE LOAD				3,000	2,400				5400 W
EQUIPMENT LOAD			12,893	12,893	12,193				37979 W
TOTAL LOAD			14,943	15,893	14,593				45429 W
									126 A
									105 A
									CONNECTED LOAD
									DEMAND LOAD

PROJECT: Linwood Apts				200A	MLO	CLASS: 120/208V-3PH-4W+G		RP-HA3	
PROJ NO: 21061				10 KAIC		MOUNTING: SURFACE			
BRANCH CIRC.	POLES	BKR.	WATTS	BUS A	BUS B	BUS C	CODE	REMARKS	
NO.							L R E		
1	2	20				1617			HHP-1-J / HHP-1-O Roof Serves 4th Flr
3	1	20				1617			
5	2	20				1617			HHP-1-J / HHP-1-O Roof Serves 4th Flr
7	1	20				1617			
9	2	20				1617			HHP-1-J / HHP-1-O Roof Serves 3rd Flr
11						1617			
13	2	20				1617			HHP-1-J / HHP-1-O Roof Serves 3rd Flr
15						1617			
17	2	20				1617			HHP-1-J / HHP-1-O Roof Serves 2nd Flr
19						1617			
21	2	20				1617			HHP-1-J / HHP-1-O Roof Serves 2nd Flr
23						1617			
25	2	20				1617			HHP-1-J / HHP-1-O Roof Serves 1st Flr
27						1617			
29	2	20				1617			HHP-1-J / HHP-1-O Roof Serves 1st Flr
31						1617			
33	1	-							SPACE
35	1	-							SPACE
37	1	-							SPACE
39	1	-							SPACE
41	1	-							SPACE
2	1	20	1600				R		Receptacles 3rd Flr Corr/Mech
4	1	20				1200	R		Receptacles 3rd Flr Corr/Mech
6	1	20				1200	R		Receptacles 4th Flr Corr/Mech
8	1	20	1600				R		Receptacles 4th Flr Corr/Mech
10	1	20				300	L		Lighting 3rd Flr Mech
12	1	20				300	L		Lighting 4th Flr Mech
14	1	20	1200				R		Receptacles Exterior Roof
16	1	20							spare
18	1	20							spare
20	1	20							spare
22	1	20							spare
24	1	20							spare
26	1	20							spare
28	1	20							spare
30	1	20							spare
32	1								SPACE
34	1								SPACE
36	1								SPACE
38	1								SPACE
40	1								SPACE
42	1								SPACE
LIGHTING LOAD				300	300				600 W
RECEPTACLE LOAD			4,400	1,200	1,200				6800 W
EQUIPMENT LOAD			9,702	8,085	8,085				25872 W
TOTAL LOAD			14,102	9,585	9,585				33272 W
									92 A
									CONNECTED LOAD
									DEMAND LOAD

PROJECT: Linwood Apts				200A	MLO	CLASS: 120/208V-3PH-4W+G		RP-EA3	
PROJ NO: 21061				10 KAIC		MOUNTING: SURFACE			
BRANCH CIRC.	POLES	BKR.	WATTS	BUS A	BUS B	BUS C	CODE	REMARKS	
NO.							L R E		
1	1	20					L		Lighting Corridor 3rd floor
3	1	20				1200	L		Lighting Corridor 3rd floor
5	1	20				1200	L		Lighting Corridor 4th floor
7	1	20	1200				L		Lighting Corridor 4th floor
9	1	20							spare
11	1	20							spare
13	1								SPACE
15	1								SPACE
2	1	20							spare
4	1	20							spare
6	1	20							spare
8	1	20							spare
10	1	20							spare
12	1	20							spare
14	1								SPACE
16	1								SPACE
18	1								SPACE
20	1								SPACE
22	1								SPACE
24	1								SPACE
26	1								SPACE
28	1								SPACE
30	1								SPACE
32	1								SPACE
34	1								SPACE
36	1								SPACE
38									
40	3	90							SPARE
42									
LIGHTING LOAD			2,400	1,200	1,200				4800 W
RECEPTACLE LOAD									NEC 220 =
EQUIPMENT LOAD									80% =
TOTAL LOAD			2,400	1,200	1,200				4800 W
									13 A
									CONNECTED LOAD
									DEMAND LOAD




104 W. Fourth Street
Suite 303
Royal Oak, Michigan 48067
248.629.7153 ph.
248.629.7154 fax
www.SHELTERSTUDIO.LLC.com

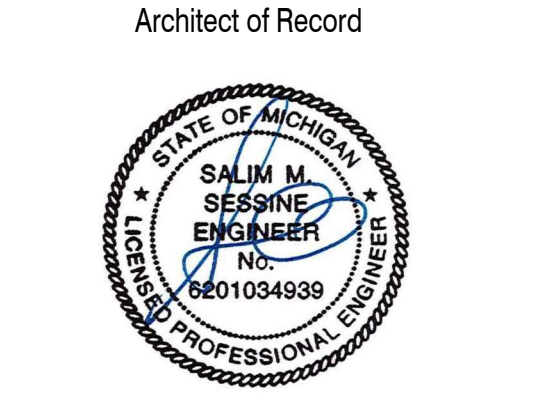

EAM Engineers, Inc.
Electrical and Mechanical Consulting Engineers
180 High Oak Road, Bloomfield Hills, MI 48304
Phone 248.528.6570 Fax 248.528.1642
www.eam-engineers.com eam@eam-engineers.com
Job No. 483-21061

Owner
DEVELOP DETROIT
1452 Randolph Street, Suite 300
Detroit, MI 48226

Project
**Apartment Renovation
LINWOOD APARTMENTS**
2295 W Grand Blvd
Detroit, MI 48208

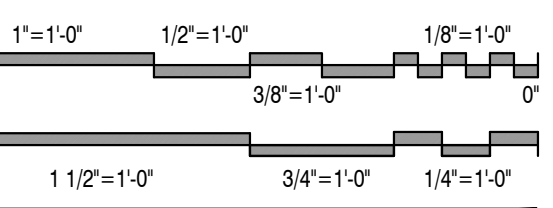

Issued For	Date
Preliminary Review	01.31.2023
Review & Bids	02.27.2023
Bids & Permits	08.12.2024
Plan Review Revisions	03.20.2025
MSHDA Revisions	05.07.2026

Drawing Title
**Electrical Panelboard
Schedules**

2021-248
Project No. JLW EK
Drawn By Checked By
As Noted
Scale

E0.5
Drawing No.



EAM Engineers, Inc.

Electrical and Mechanical Consulting Engineers
180 High Oak Road, Bloomfield Hills, MI 48304
Phone 248.528.6570 Fax 248.528.1642
www.eam-engineers.com eam@eam-engineers.com


Job No. 483-21061

Owner

DEVELOP DETROIT
1452 Randolph Street, Suite 300
Detroit, MI 48226

Project

**Apartment Renovation
LINWOOD APARTMENTS**
2295 W Grand Blvd
Detroit, MI 48208

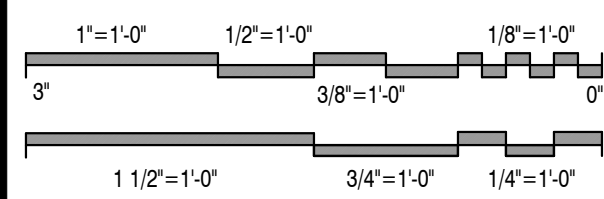

Issued For	Date
Preliminary Review	01.31.2023
Review & Bids	02.27.2023
Bids & Permits	08.12.2024
Plan Review Revisions	03.20.2025
MSHDA Revisions	05.07.2026

Drawing Title

**First Floor Plan
- Lighting**

2021-248

Project No.

JLW

Drawn By

As Noted


Scale

EK


Checked By

E1.1

Drawing No.

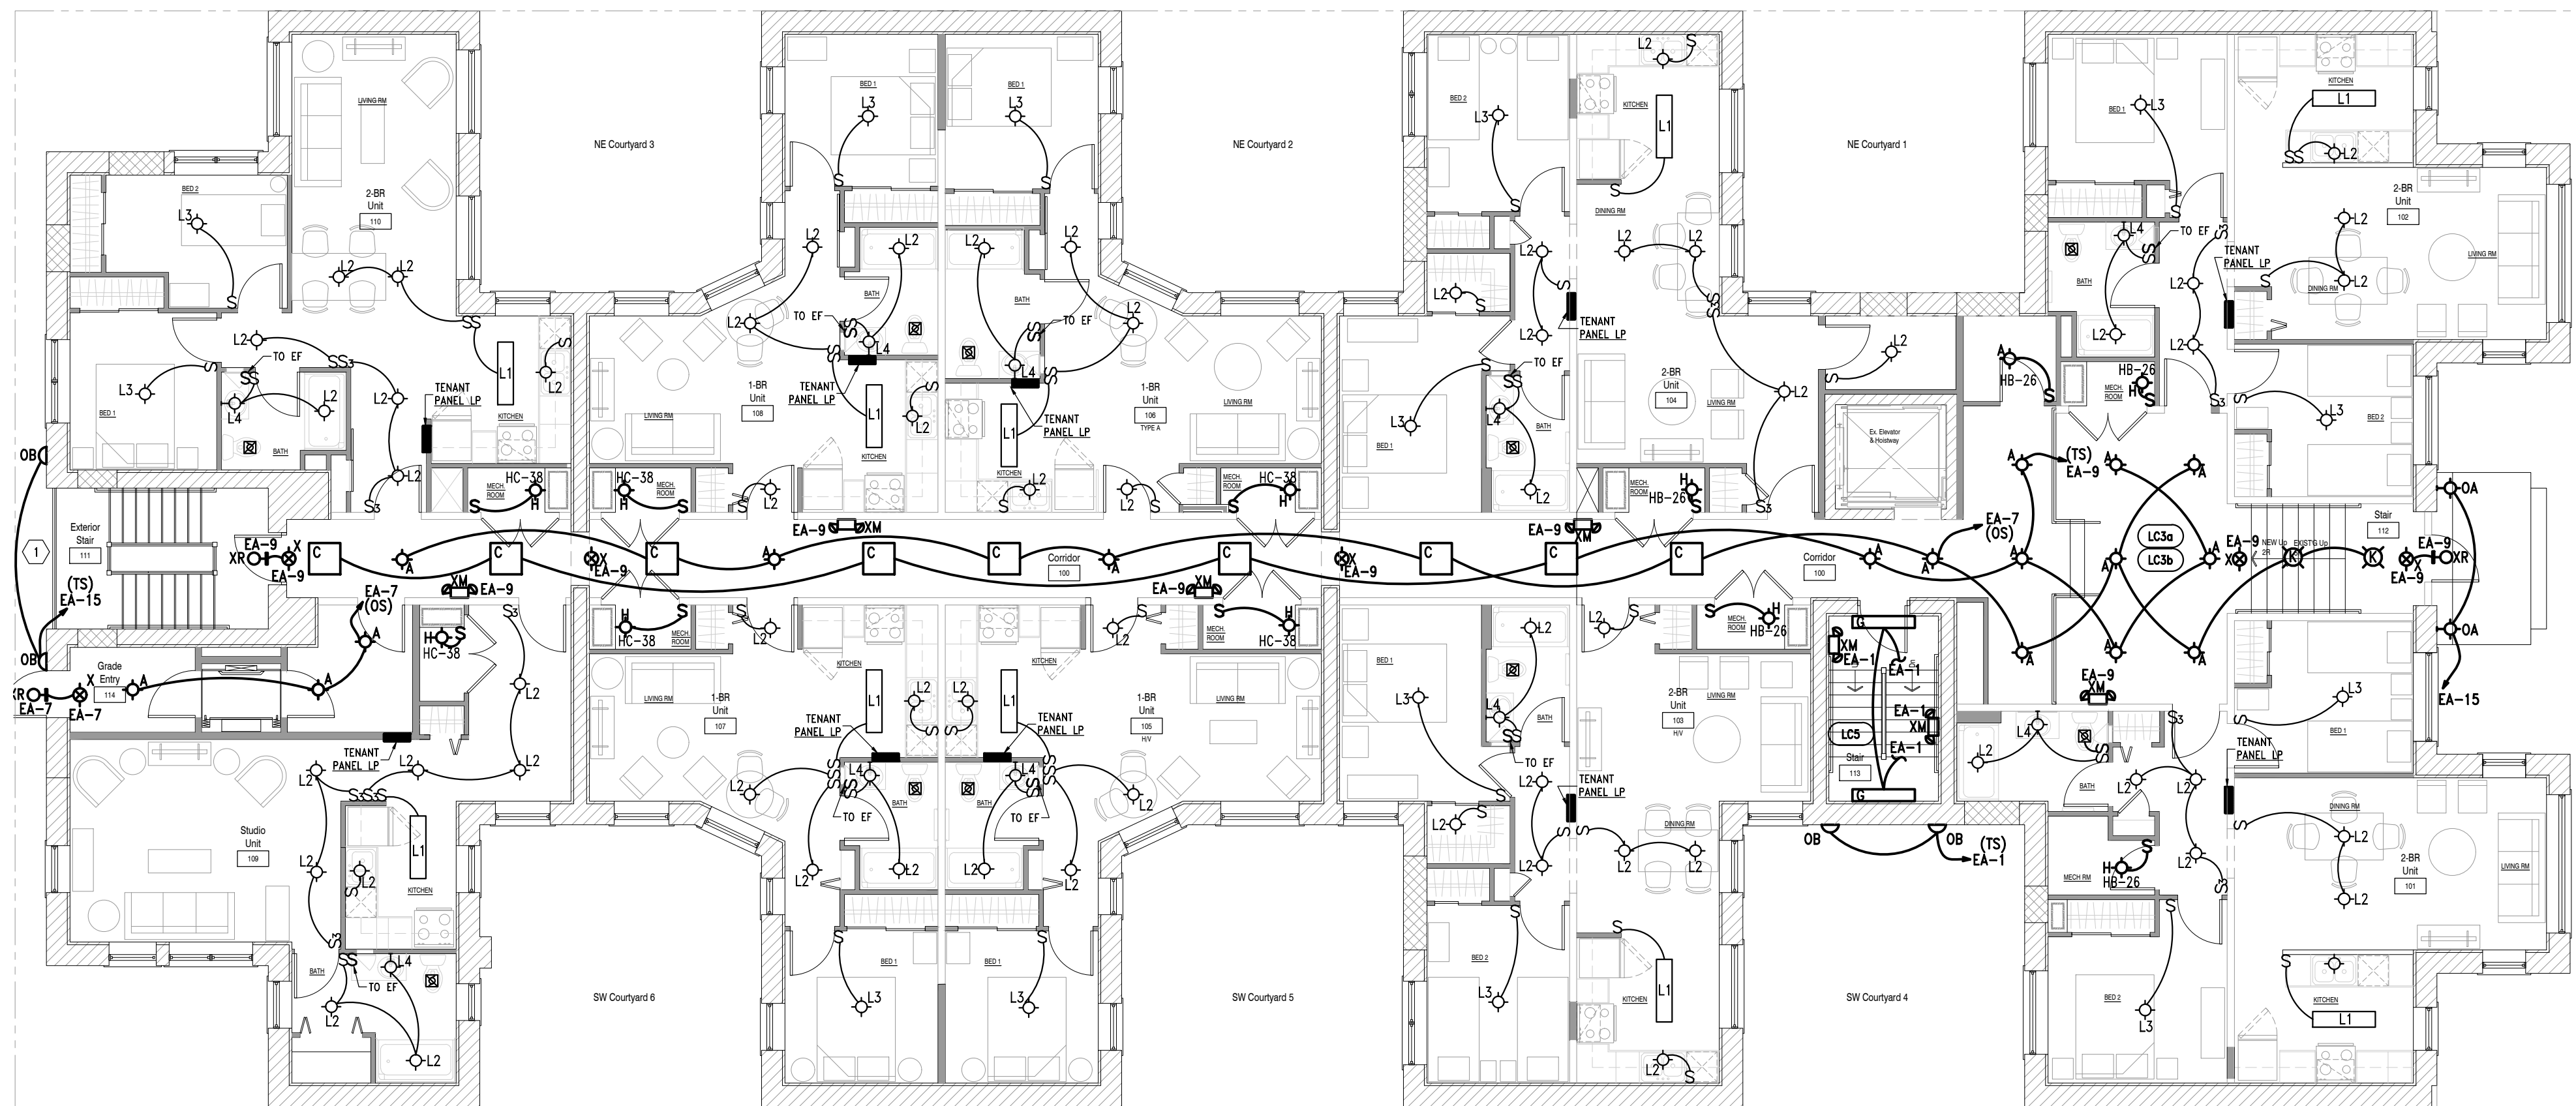

1 First Floor Plan - Lighting
E1.1 Scale: 1/8" = 1'-0"

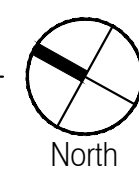

GENERAL LIGHTING NOTES:


- REFER TO SHEET E0.1 FOR ELECTRICAL LEGEND.
- REFER TO SHEET E0.2 FOR LIGHTING FIXTURE SCHEDULE AND LIGHTING CONTROL MATRIX.
- REFER TO SHEET E0.3 FOR EXTERIOR SITE LIGHTING.
- REFER TO SHEETS POWER PLANS FOR SWITCHED RECEPTACLES.
- REFER TO SHEET E0.4 FOR TYPICAL APARTMENT LP PANEL AND CIRCUITING.
- REFER TO BOOK SPEC FOR SPECIFICATIONS FOR ADDITIONAL LAMP AND BALLAST REQUIREMENTS.
- COORDINATE LIGHTING LAYOUT WITH ARCHITECTURAL REFLECTED CEILING PLANS, ELEVATIONS, SECTIONS, MECHANICAL FLOOR PLANS AND MECHANICAL DUCT WORK PRIOR TO ROUGH-IN FOR EXACT LOCATIONS AND MOUNTING OF ALL CEILING, PENDANT & WALL MOUNTED LIGHT FIXTURES.
- IN ADDITION TO THE LOCAL SWITCHES SHOWN, PROVIDE A COMPLETE OCCUPANCY SENSOR AND RELAY PANEL BASED AUTOMATIC LIGHTING CONTROL SYSTEM. NOT ALL DEVICES ARE INDICATED ON THESE PLANS. SYSTEM SHALL BE LAYED OUT ON A PERFORMANCE BASIS, TYPICAL FOR ALL ROOMS/AREAS AS SPECIFIED. REFER TO LIGHTING CONTROL MATRIX AND SPECIFICATIONS.
- ALL LAY-IN FIXTURES SHALL BE FURNISHED WITH SAFETY CHIPS AND MECHANICALLY ATTACHED TO CEILING GRID SYSTEM, SUPPORTED INDEPENDENTLY FROM BUILDING STEEL.
- ALL EXIT AND EMERGENCY LIGHT FIXTURES SHALL BE CONNECTED TO ROOM LIGHT CIRCUIT AHEAD OF LOCAL CONTROLS.
- THIS CONTRACTOR SHALL FURNISH AND INSTALL ALL LAMPS FOR ALL TYPES OF LIGHTING FIXTURES.
- ALL FIXTURE FINISHES/COLORS TO BE COORDINATED WITH ARCHITECT.
- DIMMERS TO BE COMPATIBLE WITH THE DIMMING DRIVERS, PROVIDE TYPES AND RATINGS AS REQUIRED FOR THE LOADS CONTROLLED.
- COORDINATE LOCATIONS OF ALL SWITCHES WITH DOOR LOCATIONS SHOWN ON THE ARCHITECTURAL PLANS. AT ALL SWITCHING LOCATIONS OF MULTIPLE SWITCHES, PROVIDE A SINGLE MULTI-GANG BOX WITH SINGLE COVERPLATE.
- ELECTRICAL CONTRACTOR SHALL PROVIDE POWER PACKS AND VERIFY WIRING FOR THE CEILING MOUNTED MOTION SENSOR WITH THE MANUFACTURER'S REQUIREMENTS. INSTALL MOTION SENSOR POWER PACKS ABOVE ACCESSIBLE CEILINGS.
- ALL WIRING SHALL BE SIZED PROPERLY FOR FULL COMPLIANCE WITH THE NEC REQUIREMENTS FOR AMPACITY AND MAXIMUM VOLTAGE DROP LIMITATIONS, REFER TO SHEET E0.10 FOR CIRCUIT LENGTH TABLES.
- PROPOSED EQUAL LIGHTING FIXTURES SHALL HAVE EQUAL DELIVERED LUMENS AND SHALL BE SUBMITTED FOR ARCHITECT/OWNER REVIEW AND APPROVAL PRIOR TO BID.
- ALL ELECTRICAL DEVICES SHALL BE LISTED FOR THE INTENDED USE.
- CONTRACTOR TO CONDUCT A COORDINATION MEETING WITH ALL OTHER TRADES PRIOR TO START OF THE WORK TO DETERMINE EQUIPMENT LOCATIONS AND PATHWAYS TO AVOID INTERFERENCES WITH OTHER SYSTEMS AND TO MAINTAIN THE CODE REQUIRED, DEDICATED EQUIPMENT SPACE, WORKING CLEARANCES AND ACCESS.
- ALL 120-VOLT, SINGLE PHASE, 15A AND 20A BRANCH CIRCUITS SUPPLYING LIGHTING INSTALLED IN DWELLING UNIT FAMILY ROOMS, DINING ROOMS, LIVING ROOMS, PARLORS, LIBRARIES, DEN'S, BEDROOMS, SUNROOMS, RECREATION ROOMS, CLOSETS, HALLWAYS, OR SIMILAR ROOMS OR AREAS SHALL BE PROTECTED BY A LISTED ARC-FAULT CIRCUIT INTERRUPTER, COMBINATION-TYPE, INSTALLED TO PROVIDE PROTECTION OF THE BRANCH CIRCUIT, IN ACCORDANCE WITH THE 2008 N.E.C., ARTICLE 210.12 INCLUDING SMOKE DETECTORS.
- USE #10 WIRE FOR LIGHTING CIRCUIT HOMERUNS LONGER THAN 150 FEET FROM PANEL.
- PROVIDE COMPLETE LIGHTING CONTROL SYSTEM CAPABLE OF COMPLYING WITH ALL 2017 MICHIGAN ENERGY CODE REQUIREMENTS. ONLY SCHEMATIC DEVICE LOCATIONS ARE SHOWN ON PLAN TO CONVEY CONTROL LOCATIONS INTENT. PROVIDE ALL DEVICES, WIRING, HARDWARE, AND PROGRAMMING AS REQUIRED FOR FULLY FUNCTIONAL LIGHTING CONTROL SYSTEM PER MANUFACTURER'S RECOMMENDATIONS. SYSTEM IS PERFORMANCE-BASED DESIGN BUILT BY ELECTRICAL CONTRACTOR AND THE CONTRACTOR'S SUPPLIER. TYPICAL FOR ALL ROOMS/AREAS.
- ALL LIGHTING CONTROL DEVICES AND CONTROL SYSTEMS MUST BE FUNCTIONALLY TESTED FOR PROPER OPERATION BY AN INDEPENDENT PARTY THAT IS NOT DIRECTLY INVOLVED WITH EITHER THE DESIGN OR THE CONSTRUCTION OF THE LIGHTING SYSTEM. (REFER TO ASHRAE 90.1-2013, SECTION 9.4.3 FUNCTION TESTING).

KEYED NOTES:

- REFER TO SITE PLAN, SHEET E3.0 FOR MORE EXTERIOR LIGHTING.

TAG	DESCRIPTION
-	REFER TO LIGHTING CONTROL MATRIX SCHEDULE ON SHEET E0.2 FOR MORE INFORMATION ON SPACE SPECIFIC LIGHTING CONTROLS.

ALL APARTMENT LAYOUTS REVISED

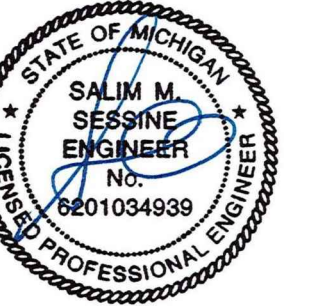

EAM Engineers, Inc.

Electrical and Mechanical Consulting Engineers
180 High Oak Road, Bloomfield Hills, MI 48304
Phone 248.528.8570 Fax 248.528.1642
www.eam-engineers.com eam@eam-engineers.com


Job No. 483-21061

Owner

DEVELOP DETROIT
1452 Randolph Street, Suite 300
Detroit, MI 48226

Project

**Apartment Renovation
LINWOOD APARTMENTS**
2295 W Grand Blvd
Detroit, MI 48208

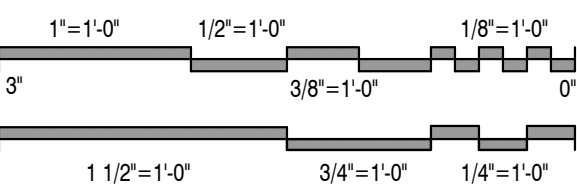

Issued For	Date
Preliminary Review	01.31.2023
Review & Bids	02.27.2023
Bids & Permits	08.12.2024
Plan Review Revisions	03.20.2025
MSHDA Revisions	05.07.2026

Drawing Title

**Second Floor Plan
- Lighting**

2021-248

Project No.

JLW

Drawn By

As Noted

Scale

E1.2

Drawing No.

EK


Checked By

As Noted

Scale

E1.2

Drawing No.

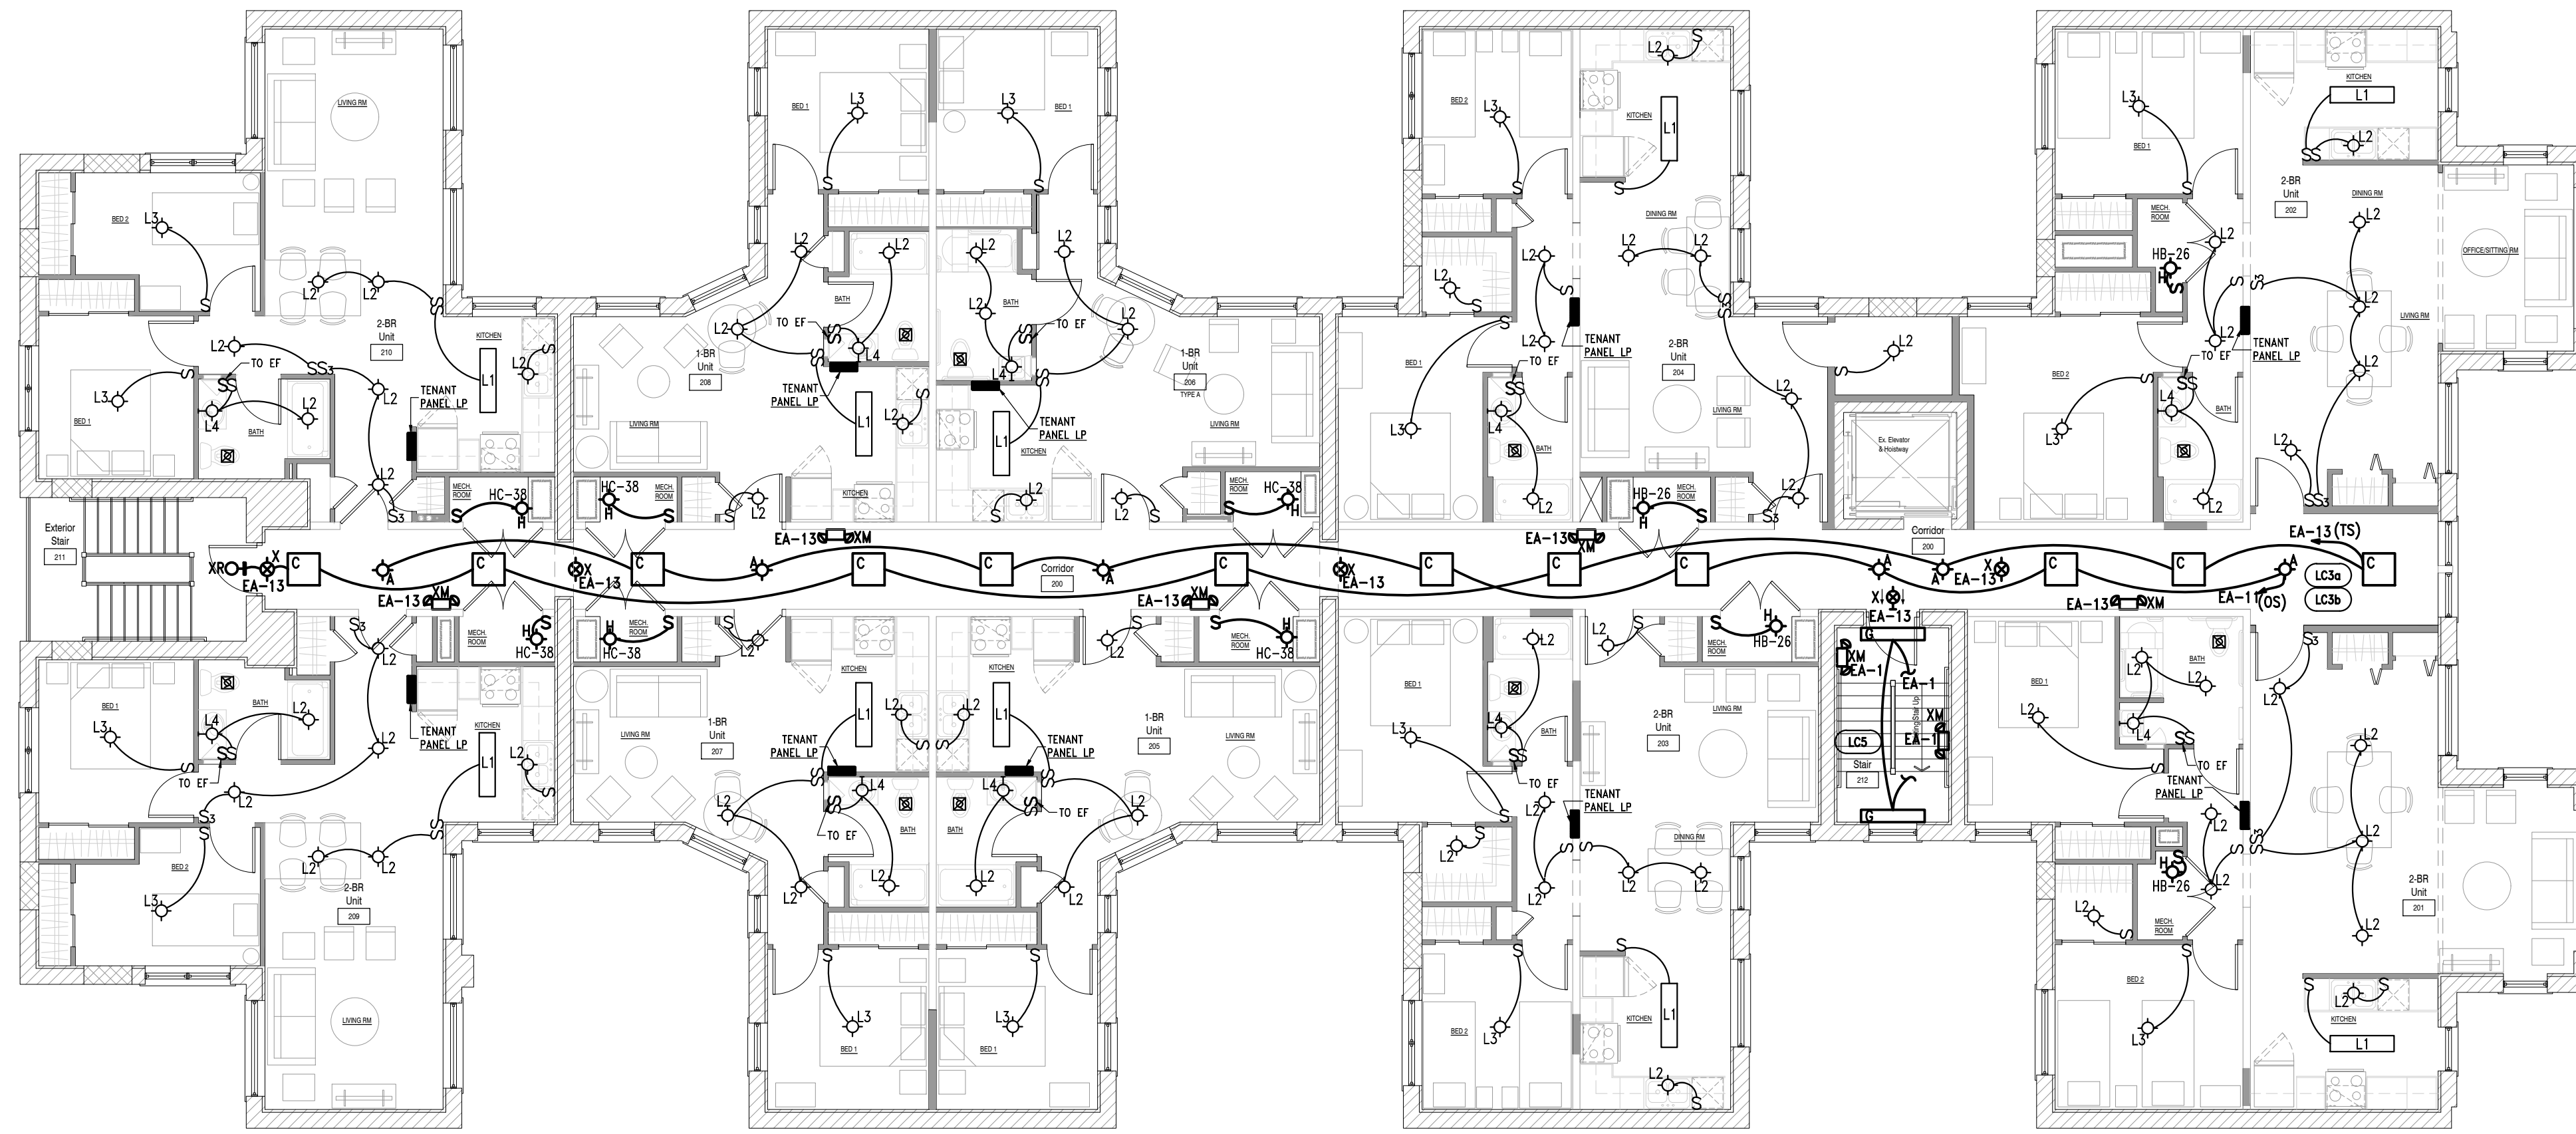

GENERAL LIGHTING NOTES:

- REFER TO SHEET E0.1 FOR ELECTRICAL LEGEND.
- REFER TO SHEET E0.2 FOR LIGHTING FIXTURE SCHEDULE AND LIGHTING CONTROL MATRIX.
- REFER TO SHEET E0.3 FOR EXTERIOR SITE LIGHTING.
- REFER TO SHEETS POWER PLANS FOR SWITCHED RECEPTACLES.
- REFER TO SHEET E0.4 FOR TYPICAL APARTMENT LP PANEL AND CIRCUITING.
- REFER TO BOOK SPEC FOR SPECIFICATIONS FOR ADDITIONAL LAMP AND BALLAST REQUIREMENTS.
- COORDINATE LIGHTING LAYOUT WITH ARCHITECTURAL REFLECTED CEILING PLANS, ELEVATIONS, SECTIONS, MECHANICAL FLOOR PLANS AND MECHANICAL DUCT WORK PRIOR TO ROUGH-IN FOR EXACT LOCATIONS AND MOUNTING OF ALL CEILING, PENDANT & WALL MOUNTED LIGHT FIXTURES.
- IN ADDITION TO THE LOCAL SWITCHES SHOWN, PROVIDE A COMPLETE OCCUPANCY SENSOR AND RELAY PANEL BASED AUTOMATIC LIGHTING CONTROL SYSTEM. NOT ALL DEVICES ARE INDICATED ON THESE PLANS. SYSTEM SHALL BE LAYED OUT ON A PERFORMANCE BASIS. TYPICAL FOR ALL ROOMS/AREAS AS SPECIFIED. REFER TO LIGHTING CONTROL MATRIX AND SPECIFICATIONS.
- ALL LAY-IN FIXTURES SHALL BE FURNISHED WITH SAFETY CHIPS AND MECHANICALLY ATTACHED TO CEILING GRID SYSTEM, SUPPORTED INDEPENDENTLY FROM BUILDING STEEL.
- ALL EXIT AND EMERGENCY LIGHT FIXTURES SHALL BE CONNECTED TO ROOM LIGHT CIRCUIT AHEAD OF LOCAL CONTROLS.
- THIS CONTRACTOR SHALL FURNISH AND INSTALL ALL LAMPS FOR ALL TYPES OF LIGHTING FIXTURES.
- ALL FIXTURE FINISHES/COLORS TO BE COORDINATED WITH ARCHITECT.
- DIMMERS TO BE COMPATIBLE WITH THE DIMMING DRIVERS, PROVIDE TYPES AND RATINGS AS REQUIRED FOR THE LOADS CONTROLLED.
- COORDINATE LOCATIONS OF ALL SWITCHES WITH DOOR LOCATIONS SHOWN ON THE ARCHITECTURAL PLANS. AT ALL SWITCHING LOCATIONS OF MULTIPLE SWITCHES, PROVIDE A SINGLE MULTI-GANG BOX WITH SINGLE COVERPLATE.
- ELECTRICAL CONTRACTOR SHALL PROVIDE POWER PACKS AND VERIFY WIRING FOR THE CEILING MOUNTED MOTION SENSOR WITH THE MANUFACTURER'S REQUIREMENTS. INSTALL MOTION SENSOR POWER PACKS ABOVE ACCESSIBLE CEILINGS.
- ALL WIRING SHALL BE SIZED PROPERLY FOR FULL COMPLIANCE WITH THE NEC REQUIREMENTS FOR AMPACITY AND MAXIMUM VOLTAGE DROP LIMITATIONS, REFER TO SHEET E0.10 FOR CIRCUIT LENGTH TABLES.
- PROPOSED EQUAL LIGHTING FIXTURES SHALL HAVE EQUAL DELIVERED LUMENS AND SHALL BE SUBMITTED FOR ARCHITECT/OWNER REVIEW AND APPROVAL PRIOR TO BID.
- ALL ELECTRICAL DEVICES SHALL BE LISTED FOR THE INTENDED USE.
- CONTRACTOR TO CONDUCT A COORDINATION MEETING WITH ALL OTHER TRADES PRIOR TO START OF THE WORK TO DETERMINE EQUIPMENT LOCATIONS AND PATHWAYS TO AVOID INTERFERENCES WITH OTHER SYSTEMS AND TO MAINTAIN THE CODE REQUIRED, DEDICATED EQUIPMENT SPACE, WORKING CLEARANCES AND ACCESS.
- ALL 120-VOLT, SINGLE PHASE, 15A AND 20A BRANCH CIRCUITS SUPPLYING LIGHTING INSTALLED IN DWELLING UNIT FAMILY ROOMS, DINING ROOMS, LIVING ROOMS, PARLORS, LIBRARIES, DENS, BEDROOMS, SUNROOMS, RECREATION ROOMS, CLOSETS, HALLWAYS, OR SIMILAR ROOMS OR AREAS SHALL BE PROTECTED BY A LISTED ARC-FAULT CIRCUIT INTERRUPTER, COMBINATION-TYPE, INSTALLED TO PROVIDE PROTECTION OF THE BRANCH CIRCUIT, IN ACCORDANCE WITH THE 2008 N.E.C., ARTICLE 210.12 INCLUDING SMOKE DETECTORS.
- USE #10 WIRE FOR LIGHTING CIRCUIT HOMERUNS LONGER THAN 150 FEET FROM PANEL.
- PROVIDE COMPLETE LIGHTING CONTROL SYSTEM CAPABLE OF COMPLYING WITH ALL 2017 MICHIGAN ENERGY CODE REQUIREMENTS. ONLY SCHEMATIC DEVICE LOCATIONS ARE SHOWN ON PLAN TO CONVEY CONTROL LOCATIONS INTENT. PROVIDE ALL DEVICES, WIRING, HARDWARE, AND PROGRAMMING AS REQUIRED FOR FULLY FUNCTIONAL LIGHTING CONTROL SYSTEM PER MANUFACTURER'S RECOMMENDATIONS. SYSTEM IS PERFORMANCE-BASED DESIGN BUILT BY ELECTRICAL CONTRACTOR AND THE CONTRACTOR'S SUPPLIER. TYPICAL FOR ALL ROOMS/AREAS.
- ALL LIGHTING CONTROL DEVICES AND CONTROL SYSTEMS MUST BE FUNCTIONALLY TESTED FOR PROPER OPERATION BY AN INDEPENDENT PARTY THAT IS NOT DIRECTLY INVOLVED WITH EITHER THE DESIGN OR THE CONSTRUCTION OF THE LIGHTING SYSTEM. (REFER TO ASHRAE 90.1-2013, SECTION 9.4.3 FUNCTION TESTING).

KEYED NOTES:


- REFER TO SITE PLAN, SHEET E3.0 FOR MORE EXTERIOR LIGHTING.

TAG	DESCRIPTION
(Symbol)	REFER TO LIGHTING CONTROL MATRIX SCHEDULE ON SHEET E0.2 FOR MORE INFORMATION ON SPACE SPECIFIC LIGHTING CONTROLS.

ALL APARTMENT LAYOUTS REVISED

1 Second Floor Plan - Lighting

E1.2 Scale: 1/8" = 1'-0"

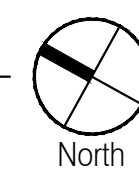



EAM Engineers, Inc.

Electrical and Mechanical Consulting Engineers
180 High Oak Road, Bloomfield Hills, MI 48304
Phone 248.528.8570 Fax 248.528.1642
www.eam-engineers.com eam@eam-engineers.com


Job No. 483-21061

Owner

DEVELOP DETROIT
1452 Randolph Street, Suite 300
Detroit, MI 48226

Project

**Apartment Renovation
LINWOOD APARTMENTS**
2295 W Grand Blvd
Detroit, MI 48208

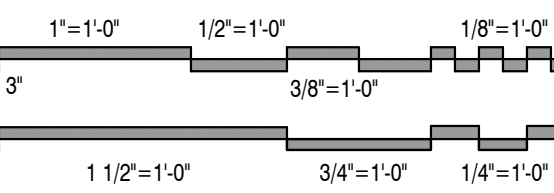

Issued For	Date
Preliminary Review	01.31.2023
Review & Bids	02.27.2023
Bids & Permits	08.12.2024
Plan Review Revisions	03.20.2025
MSHDA Revisions	05.07.2026

Drawing Title

**Fourth Floor Plan
- Lighting**

2021-248

Project No.

JLW

Drawn By

As Noted


Scale

EK

Checked By

E1.4

Drawing No.

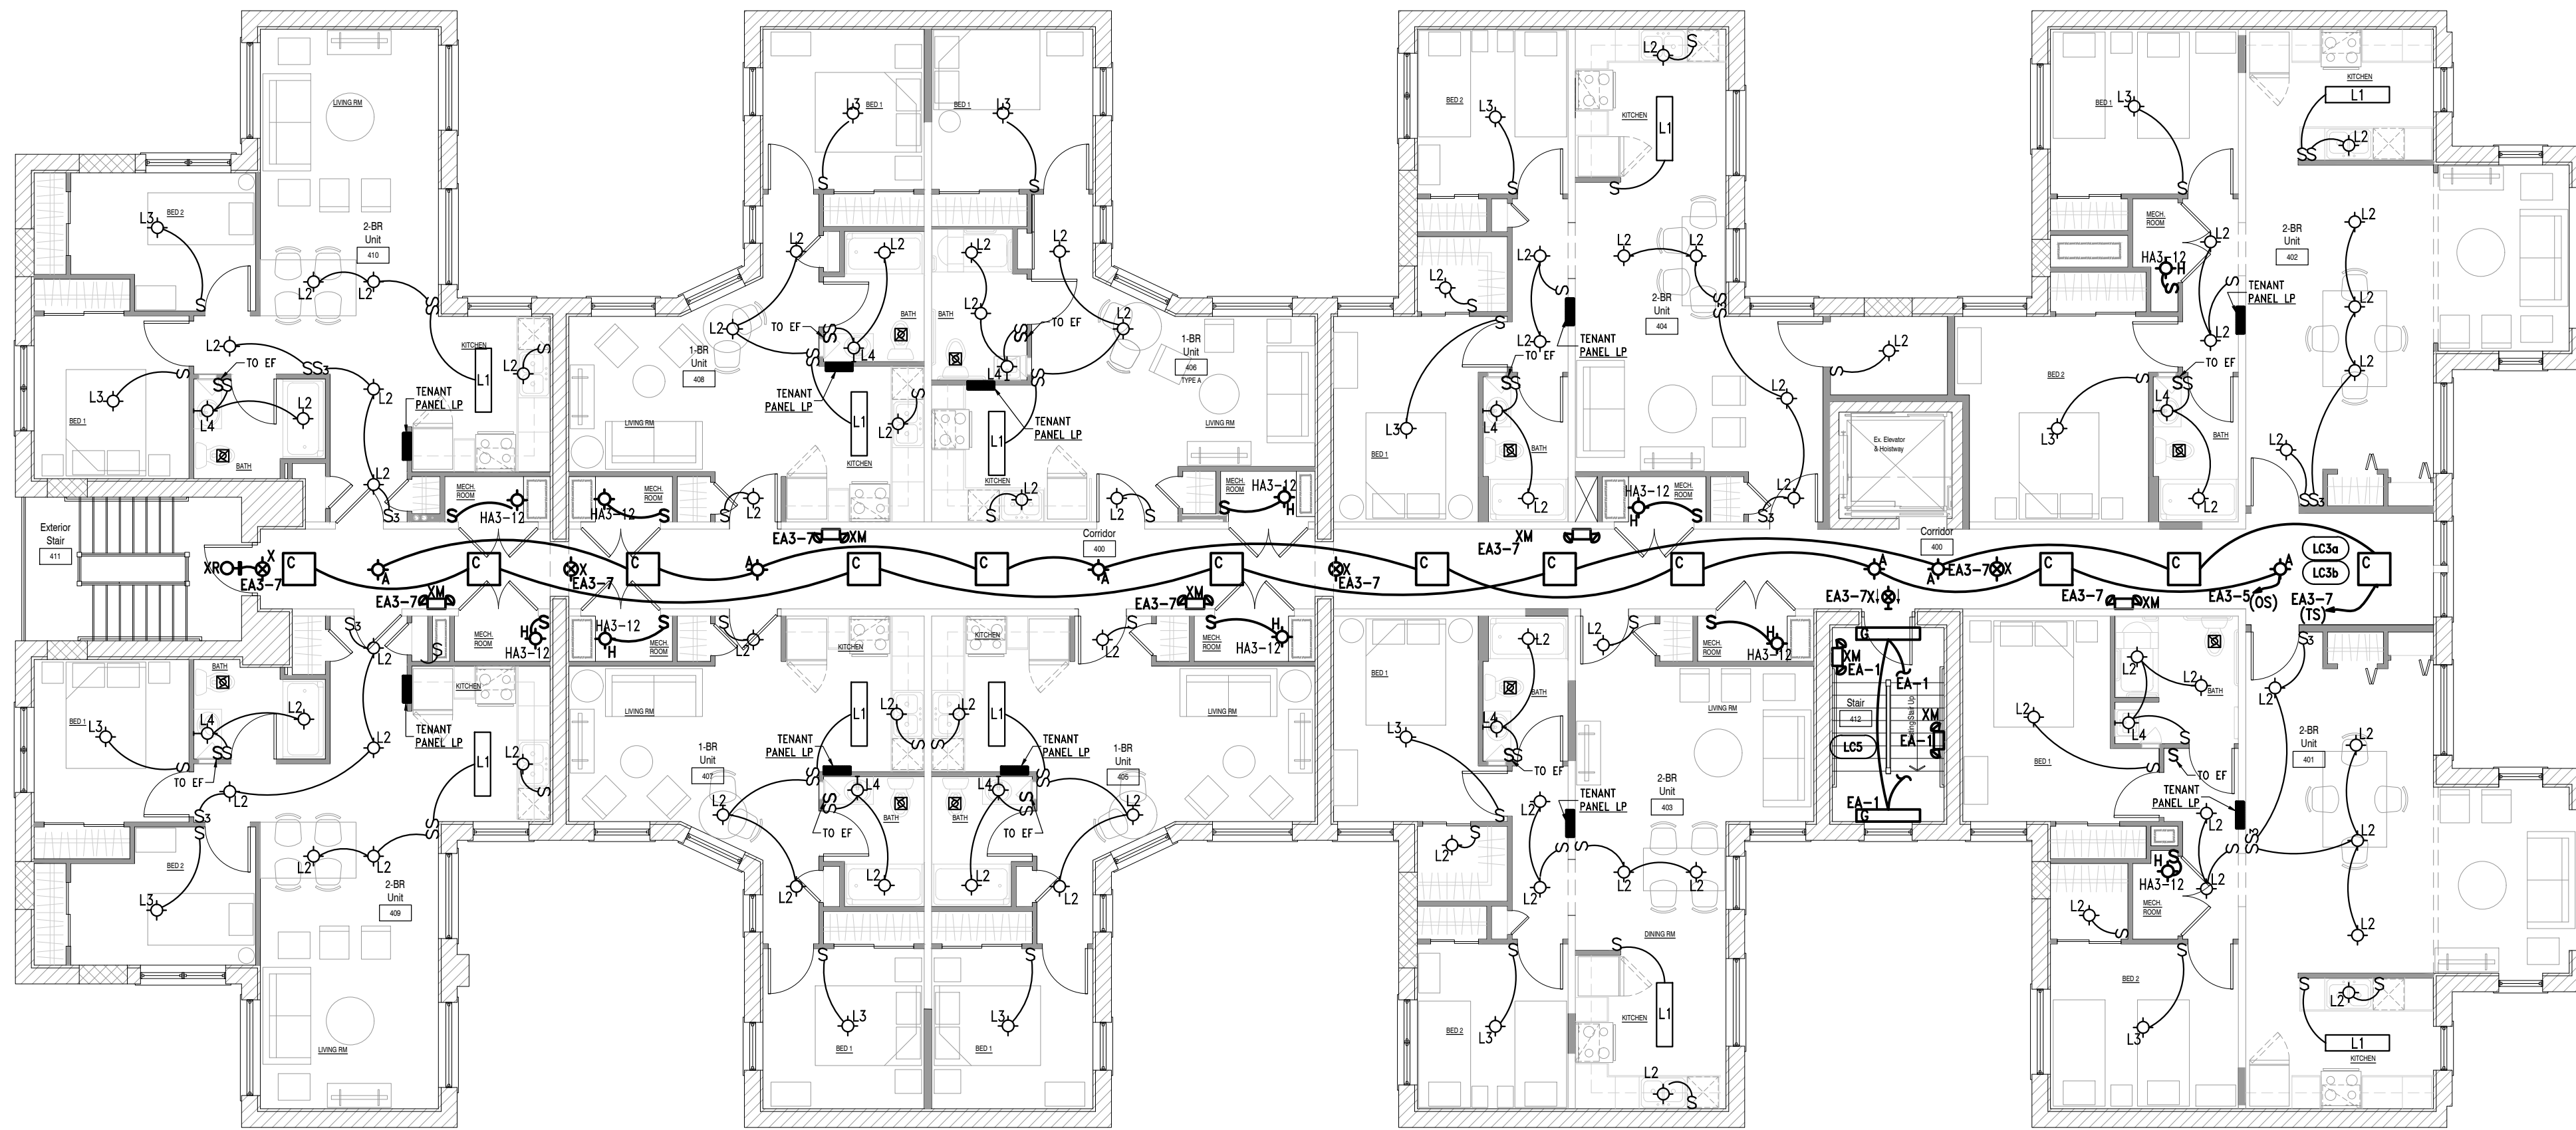

1 Fourth Floor Plan - Lighting
E1.4 Scale: 1/8" = 1'-0"
North

GENERAL LIGHTING NOTES:

- REFER TO SHEET E0.1 FOR ELECTRICAL LEGEND.
- REFER TO SHEET E0.2 FOR LIGHTING FIXTURE SCHEDULE AND LIGHTING CONTROL MATRIX.
- REFER TO SHEET E0.3 FOR EXTERIOR SITE LIGHTING.
- REFER TO SHEETS POWER PLANS FOR SWITCHED RECEPTACLES.
- REFER TO SHEET E0.4 FOR TYPICAL APARTMENT LP PANEL AND CIRCUITING.
- REFER TO BOOK SPEC FOR SPECIFICATIONS FOR ADDITIONAL LAMP AND BALLAST REQUIREMENTS.
- COORDINATE LIGHTING LAYOUT WITH ARCHITECTURAL REFLECTED CEILING PLANS, ELEVATIONS, SECTIONS, MECHANICAL FLOOR PLANS AND MECHANICAL DUCT WORK PRIOR TO ROUGH-IN FOR EXACT LOCATIONS AND MOUNTING OF ALL CEILING, PENDANT & WALL MOUNTED LIGHT FIXTURES.
- IN ADDITION TO THE LOCAL SWITCHES SHOWN, PROVIDE A COMPLETE OCCUPANCY SENSOR AND RELAY PANEL BASED AUTOMATIC LIGHTING CONTROL SYSTEM. NOT ALL DEVICES ARE INDICATED ON THESE PLANS. SYSTEM SHALL BE LAYED OUT ON A PERFORMANCE BASIS, TYPICAL FOR ALL ROOMS/AREAS AS SPECIFIED. REFER TO LIGHTING CONTROL MATRIX AND SPECIFICATIONS.
- ALL LAY-IN FIXTURES SHALL BE FURNISHED WITH SAFETY CHIPS AND MECHANICALLY ATTACHED TO CEILING GRID SYSTEM, SUPPORTED INDEPENDENTLY FROM BUILDING STEEL.
- ALL EXIT AND EMERGENCY LIGHT FIXTURES SHALL BE CONNECTED TO ROOM LIGHT CIRCUIT AHEAD OF LOCAL CONTROLS.
- THIS CONTRACTOR SHALL FURNISH AND INSTALL ALL LAMPS FOR ALL TYPES OF LIGHTING FIXTURES.
- ALL FIXTURE FINISHES/COLORS TO BE COORDINATED WITH ARCHITECT.
- DIMMERS TO BE COMPATIBLE WITH THE DIMMING DRIVERS, PROVIDE TYPES AND RATINGS AS REQUIRED FOR THE LOADS CONTROLLED.
- COORDINATE LOCATIONS OF ALL SWITCHES WITH DOOR LOCATIONS SHOWN ON THE ARCHITECTURAL PLANS. AT ALL SWITCHING LOCATIONS OF MULTIPLE SWITCHES, PROVIDE A SINGLE MULTI-GANG BOX WITH SINGLE COVERPLATE.
- ELECTRICAL CONTRACTOR SHALL PROVIDE POWER PACKS AND VERIFY WIRING FOR THE CEILING MOUNTED MOTION SENSOR WITH THE MANUFACTURER'S REQUIREMENTS. INSTALL MOTION SENSOR POWER PACKS ABOVE ACCESSIBLE CEILING.
- ALL WIRING SHALL BE SIZED PROPERLY FOR FULL COMPLIANCE WITH THE NEC REQUIREMENTS FOR AMPACITY AND MAXIMUM VOLTAGE DROP LIMITATIONS, REFER TO SHEET E0.10 FOR CIRCUIT LENGTH TABLES.
- PROPOSED EQUAL LIGHTING FIXTURES SHALL HAVE EQUAL DELIVERED LUMENS AND SHALL BE SUBMITTED FOR ARCHITECT/OWNER REVIEW AND APPROVAL PRIOR TO BID.
- ALL ELECTRICAL DEVICES SHALL BE LISTED FOR THE INTENDED USE.
- CONTRACTOR TO CONDUCT A COORDINATION MEETING WITH ALL OTHER TRADES PRIOR TO START OF THE WORK TO DETERMINE EQUIPMENT LOCATIONS AND PATHWAYS TO AVOID INTERFERENCES WITH OTHER SYSTEMS AND TO MAINTAIN THE CODE REQUIRED, DEDICATED EQUIPMENT SPACE, WORKING CLEARANCES AND ACCESS.
- ALL 120-VOLT, SINGLE PHASE, 15A AND 20A BRANCH CIRCUITS SUPPLYING LIGHTING INSTALLED IN DWELLING UNIT FAMILY ROOMS, DINING ROOMS, LIVING ROOMS, PARLORS, LIBRARIES, DEN'S, BEDROOMS, SUNROOMS, RECREATION ROOMS, CLOSETS, HALLWAYS, OR SIMILAR ROOMS OR AREAS SHALL BE PROTECTED BY A LISTED ARC-FAULT CIRCUIT INTERRUPTER, COMBINATION-TYPE, INSTALLED TO PROVIDE PROTECTION OF THE BRANCH CIRCUIT, IN ACCORDANCE WITH THE 2008 N.E.C., ARTICLE 210.12 INCLUDING SMOKE DETECTORS.
- USE #10 WIRE FOR LIGHTING CIRCUIT HOMERUNS LONGER THAN 150 FEET FROM PANEL.
- PROVIDE COMPLETE LIGHTING CONTROL SYSTEM CAPABLE OF COMPLYING WITH ALL 2017 MICHIGAN ENERGY CODE REQUIREMENTS. ONLY SCHEMATIC DEVICE LOCATIONS ARE SHOWN ON PLAN TO CONVEY CONTROL LOCATIONS INTENT, PROVIDE ALL DEVICES, WIRING, HARDWARE, AND PROGRAMMING AS REQUIRED FOR FULLY FUNCTIONAL LIGHTING CONTROL SYSTEM PER MANUFACTURER'S RECOMMENDATIONS. SYSTEM IS PERFORMANCE-BASED DESIGN BUILT BY ELECTRICAL CONTRACTOR AND THE CONTRACTOR'S SUPPLIER. TYPICAL FOR ALL ROOMS/AREAS.
- ALL LIGHTING CONTROL DEVICES AND CONTROL SYSTEMS MUST BE FUNCTIONALLY TESTED FOR PROPER OPERATION BY AN INDEPENDENT PARTY THAT IS NOT DIRECTLY INVOLVED WITH EITHER THE DESIGN OR THE CONSTRUCTION OF THE LIGHTING SYSTEM. (REFER TO ASHRAE 90.1-2013, SECTION 9.4.3 FUNCTION TESTING).


KEYED NOTES:

- REFER TO SITE PLAN, SHEET E3.0 FOR MORE EXTERIOR LIGHTING.

TAG	DESCRIPTION
(Symbol)	REFER TO LIGHTING CONTROL MATRIX SCHEDULE ON SHEET E0.2 FOR MORE INFORMATION ON SPACE SPECIFIC LIGHTING CONTROLS.

ALL APARTMENT LAYOUTS REVISED

H:\EAM-MAIN\Projects\2021\483 Shelter Studio Design\21061 Linwood Apartments\CAD\ELECTRICAL\E1.4 Floor Plans - Lighting.dwg, 6/2/2026 11:57:59 AM, jwatson

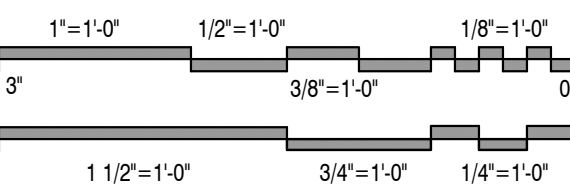

Issued For	Date
Preliminary Review	01.31.2023
Review & Bids	02.27.2023
Bids & Permits	08.12.2024
Plan Review Revisions	03.20.2025
MSHDA Revisions	05.07.2026

Drawing Title	
Basement Floor Plan - Power	
2021-248	
Project No.	
JLW	EK
Drawn By	Checked By
As Noted	
Scale	


2021-248	
Project No.	
JLW	EK
Drawn By	Checked By
As Noted	
Scale	
E2.0	
Drawing No.	

GENERAL POWER NOTES:

- REFER TO TYPICAL APARTMENT UP PANELBOARD SCHEDULE SHEET E0.4 FOR TYPICAL APARTMENT CIRCUITS.
- REFER TO E2.5 FOR MECHANICAL EQUIPMENT WIRING SCHEDULES; COORDINATE WITH MECHANICAL CONTRACTOR.
- COORDINATE LOCATION OF ALL ELECTRICAL PANELS IN ROOMS WITH ARCHITECTURAL PLANS AND OTHER TRADES TO MAINTAIN REQUIRED CLEARANCES. NO MECHANICAL DUCTS, PIPING OR EQUIPMENT SHALL BE INSTALLED IN OR ABOVE ELECTRICAL EQUIPMENT SPACE PER N.E.C.
- REFER TO MECHANICAL FLOOR PLANS, SCHEDULES AND DIAGRAMS FOR EXACT LOCATION OF EQUIPMENT AND WIRING REQUIREMENTS.
- ELECTRICAL TRADES CONTRACTOR SHALL VERIFY FUSE AND WIRE SIZES FOR ALL MECHANICAL AND MISCELLANEOUS EQUIPMENT, ETC., PER MANUFACTURER'S REQUIREMENTS AND/OR SHOP DRAWINGS. PROVIDE ALL NECESSARY STARTERS, THERMAL OVERLOADS, INTERLOCKING, 120 VOLT CONTROL WIRING, DISCONNECT SWITCHES, ETC. REQUIRED FOR A COMPLETE INSTALLATION. MAKE ALL NECESSARY REVISIONS FOR THE EXACT LOCATION OF ALL ROOF MOUNTED MECHANICAL EQUIPMENT. SEE MECHANICAL DRAWINGS. VERIFY EXACT CONDUIT STUB-UP LOCATIONS IN FIELD. ALL ROOF MOUNTED EQUIPMENT TO BE NEMA 3R WEATHERPROOF RATED, INCLUDING STARTERS, DISCONNECTS, ETC.
- EXACT LOCATIONS AND REQUIREMENTS FOR ALL EQUIPMENT AND OUTLETS FOR THE EQUIPMENT SHALL BE VERIFIED WITH OWNER, EQUIPMENT SUPPLIER AND ARCHITECT PRIOR TO INSTALLATION AND ALL EQUIPMENT SHALL BE PER MANUFACTURER'S INSTALLATION REQUIREMENTS INCLUDING FLOOR OUTLETS. LOCATE DISCONNECT SWITCHES FOR MECHANICAL AND BUILDING EQUIPMENT TO MAINTAIN WORKING CLEARANCES. LOCATIONS ON THESE PLANS ARE FOR REFERENCE ONLY. COORDINATE EXACT REQUIREMENTS WITH OWNER AND SYSTEM VENDORS. FIRE ALARM TO BE CONNECTED TO THE AV RACK. PROVIDE FIRE ALARM CABLE AND COMPONENTS, COORDINATE WITH AV VENDOR FOR CONNECTION AND EXACT REQUIREMENTS.
- COORDINATE EXACT LOCATIONS, MOUNTING HEIGHTS & REQUIREMENTS FOR ALL DEVICES WITH LATEST ARCHITECTURAL AND INTERIOR DESIGN PLANS, FURNITURE PLANS & EQUIPMENT LAYOUTS & ELEVATIONS.
- MAINTAIN A MINIMUM OF 24" HORIZONTAL SEPARATION BETWEEN BOXES INSTALLED ON OPPOSITE SIDES OF FIRE RATED WALLS TO COMPLY WITH NEC 300.21.
- PROVIDE FIRE STOPPING SYSTEM WHERE REQUIRED TO MAINTAIN THE FIRE RESISTANCE RATINGS OF THE NEW AND EXISTING ASSEMBLIES.
- CONTRACTOR TO CONDUCT A COORDINATION MEETING WITH ALL OTHER TRADES PRIOR TO START OF THE WORK TO DETERMINE EQUIPMENT LOCATIONS AND PATHWAYS TO AVOID INTERFERENCES WITH OTHER SYSTEMS AND TO MAINTAIN THE CODE REQUIRED, DEDICATED EQUIPMENT SPACE, WORKING CLEARANCES AND ACCESS.
- ALL 20 AMP BRANCH CIRCUITS LONGER THAN 100'-0" SHALL UTILIZE A MINIMUM OF #10 WIRES FOR VOLTAGE DROP. ALL 30 AMP BRANCH CIRCUITS LONGER THAN 100'-0" SHALL UTILIZE A MINIMUM OF #8 WIRES FOR VOLTAGE DROP. MAXIMUM OF 3% AT DESIGN LOAD.
- PROVIDE GROUND FAULT INTERRUPTER TYPE RECEPTACLES FOR ALL RECEPTACLES WITHIN 6'-0" OF WATER SOURCES AND SINKS, INCLUDING ALL RECEPTACLES AT MILLWORK, KITCHEN AND BATHS. GROUND-FAULT CIRCUIT INTERRUPTER PROTECTION FOR PERSONNEL SHALL BE PROVIDED AS REQUIRED IN 210.8 (A) THROUGH (E). THE GROUND-FAULT CIRCUIT INTERRUPTER SHALL BE INSTALLED IN A READILY ACCESSIBLE LOCATION, OTHER THAN DWELLING UNITS. ALL SINGLE PHASE RECEPTACLES RATED 150 VOLTS TO GROUND OR LESS, 100 AMPERES OR LESS INSTALLED IN BATHROOMS, KITCHENS, ROOFTOPS, OUTDOORS, SINKS, INDOOR WET LOCATIONS, LOCKER ROOMS, GARAGES, CRAWLSPACES, AND UNFINISHED PORTIONS OF BASEMENTS SHALL HAVE GROUND-FAULT CIRCUIT INTERRUPTER PROTECTION FOR PERSONNEL. PROVIDE GROUND FAULT BLANK FACE DEVICE AT ACCESSIBLE LOCATION OR PROVIDE GFCI BRANCH BREAKER IN PANELBOARD IF NOT READILY ACCESSIBLE.
- A CEILING PLENUM SYSTEM MAY BE USED THROUGHOUT. ALL MECHANICAL & ELECTRICAL WORK LOCATED IN THE PLENUM CEILING SHALL BE INSTALLED USING PLENUM RATED MATERIALS.
- ALL DEVICES AT COUNTER LOCATIONS TO BE MOUNTED ABOVE THE COUNTER AT 42" AFF OR AS NOTED ON THESE PLANS. COORDINATE WITH ARCHITECT/OWNER AND MILLWORK CONTRACTOR FOR EXACT LOCATIONS.
- ALL RECEPTACLES IN COUNTER AREA TO BE MOUNTED ON INSIDE WALLS OF CABINETS. ROUTE CONDUIT AND BRANCH WIRING THRU BASE CONCEALED.
- PROVIDE A COMPLETE MANUAL/AUTOMATIC ADDRESSABLE FIRE ALARM DETECTION AND NOTIFICATION SYSTEM. INCLUDE ALL WORK FOR A COMPLETE, FUNCTIONING AND APPROVED INSTALLATION. DEVICES ARE NOT SPECIFICALLY INDICATED ON THESE PLANS. SYSTEM SHALL BE LAYED OUT ON A PERFORMANCE BASIS BY A CERTIFIED DESIGNER. EMPLOY THE SERVICES OF A QUALIFIED CERTIFIED FIRE ALARM CONTRACTOR/CONSULTANT TO PREPARE THE SYSTEM DESIGN AND RELATED CONSTRUCTION DOCUMENTS INCLUDING ALL RELATED CALCULATIONS, DEVICE PLACEMENT, ALL CONTROL, MONITORING, POWER SUPPLIES, INITIATING DEVICES, INDICATING APPLIANCES, CONTROL MODULES AND WIRING AS REQUIRED; AND INCLUDE COORDINATION WITH OTHER SUPPLIERS/CONTRACTORS SUCH AS DESIGN-BUILD FIRE PROTECTION INSTALLER FULLY COMPLETE WITH ALL INFORMATION AND RELATED DATA, AS REQUIRED, TO OBTAIN SYSTEM APPROVAL BY THE AUTHORITIES HAVING JURISDICTION, DETERMINING THE APPLICABLE AUTHORITIES HAVING JURISDICTION FOR PROJECT AND INCLUDE ALL IN PLAN REVIEW, PERMITTING, AND INSPECTION. FIRE ALARM SYSTEM SHALL BE CAPABLE OF COMMUNICATING WITH THE EMERGENCY NURSE CALL SYSTEM.
- VERIFY EXACT QUANTITY AND LOCATION OF FLOW SWITCHES, TAMPER SWITCHES, AIR SUPERVISORY AND PRESSURE SWITCHES WITH FIRE PROTECTION CONTRACTOR IF REQUIRED.
- ON ALL EXHAUST FANS (EF'S), 120 VOLT SERVICE DISCONNECT SWITCHES SHALL BE FURNISHED AND INSTALLED BY MECHANICAL TRADES AND WIRED BY ELECTRICAL TRADES.
- ALL 120-VOLT SINGLE PHASE, 15A AND 20A BRANCH CIRCUITS SUPPLYING OUTLETS INSTALLED IN DWELLING UNIT FAMILY ROOMS, DINING ROOMS, LIVING ROOMS, PARLORS, LIBRARIES, DEN'S, BEDROOMS, SUNROOMS, RECREATION ROOMS, CLOSETS, HALLWAYS, OR SIMILAR ROOMS OR AREAS SHALL BE PROTECTED BY A LISTED ARC-Fault Circuit Interrupter (AFCI) TYPE, INSTALLED TO PROVIDE PROTECTION OF THE BRANCH CIRCUIT, IN ACCORDANCE WITH THE LATEST N.E.C., ARTICLE 210.12 INCLUDING SMOKE DETECTOR'S.
- FOR ALL LOW VOLTAGE SYSTEMS: SECURITY, ACCESS CONTROL, SOUND, PAGING, TWO-WAY, ETC. COORDINATE WITH ALL OWNER FOR EXACT SCOPE OF WORK TO BE INCLUDED IN THE BIDS. THESE SYSTEMS ARE NOT SPECIFICALLY INDICATED ON THESE PLANS. PROVIDE ALL REQUIRED BRANCH CIRCUITS, BACK BOXES, RACEWAYS, CONDUITS, REEVE'S AS DIRECTED BY OWNER AND OWNER VENDORS. VERIFY DEVICE LOCATIONS, QUANTITIES AND ALL REQUIREMENTS.
- IF REQUIRED BY THE LOCAL AHJ PROVIDE AREA OF REFUGE SYSTEM, REFER TO ARCHITECTURAL LIFE SAFETY PLANS FOR DESIGNATED AREAS. PROVIDE MASTER STATION CONTROL PANEL, POWER, REMOTE CALL STATIONS AND SIGNAGE, AS REQUIRED AND CONNECTED TO THE FIRE ALARM SYSTEM, INCLUDE ALL COMPONENTS FOR A COMPLETE AND APPROVED INSTALLATION.
- IF REQUIRED BY THE LOCAL AHJ PROVIDE TWO-WAY COMMUNICATION ENHANCEMENT SYSTEMS PER THE REQUIREMENTS OF NFPA 1 TO MAINTAIN THE FIRE DEPARTMENT COMMUNICATIONS AT THE LEVEL DETERMINED BY THE AHJ. SYSTEM TO INCLUDE UL LISTED FCC COMPLIANT COMPONENTS, BDA AMPLIFIERS, INDOOR AND OUTDOOR ANTENNAS, ATTENERS, BACK BOXES, RACEWAYS, SUPPORTS, WIRING, ETC. AS REQUIRED BY AUTHORITIES HAVING JURISDICTION FOR COMPLETE COVERAGE AND APPROVED INSTALLATION. SYSTEM SHALL BE LAYED OUT ON A PERFORMANCE BASIS. DEVICES ARE NOT INDICATED ON PLANS. THESE SYSTEMS ARE NOT SPECIFICALLY INDICATED ON THESE PLANS. PROVIDE ALL REQUIRED BRANCH CIRCUITS, BACK BOXES, RACEWAYS, CONDUITS, REEVE'S AS DIRECTED BY OWNER AND OWNER VENDORS. VERIFY DEVICE LOCATIONS, QUANTITIES AND ALL REQUIREMENTS. PATHWAY SURVIVABILITY, DEDICATED STORAGE BATTERY SYSTEM, ETC.

KEYED EQUIPMENT POWER NOTES:

- (P1) MICROWAVE/HOOD: 120V; GFCI BREAKER, ABOVE RANGE. VERIFY EXACT LOCATION PRIOR TO ROUGH-IN.
- (P2) RANGE: 50A-125/250V-3P-4W, NEMA 14-50 REC (VERIFY).
- (P3) 3#8+1#10 GRD-3/4" (50A-2P C.B.)
- (P4) REFRIGERATOR: 120V, GFCI BREAKER
- (P5) DISPOSAL: 120V, GFCI
- (P6) +42"A.F.F.; GFCI
- (P7) DISHWASHER: 120V; GFCI
- (P8) WASHER: 120V-1#
- (P9) ELECTRIC DRYER: 208V-1#
- (P10) 2#10+1#10 GRD-3/4" (30A-2P C.B.)
- (P11) GAS WATER HEATER: 120V PLUG & CORD (DWH-1, DWH-2, DWH-3)
- (P12) COMBINATION FIRE/SMOKE DAMPER, 120V, TIE INTO FIRE ALARM SYSTEM.
- (P13) RANGE HOOD (ADA UNIT): 120V; ABOVE RANGE. VERIFY EXACT LOCATION PRIOR TO ROUGH-IN. REFER TO ARCHITECTURAL ELEVATION FOR RANGEHOOD AND LIGHT SWITCHES LOCATIONS.
- (P14) MICROWAVE (ADA UNIT): 120V; ON COUNTER, COORDINATE WITH ARCHITECTURAL; VERIFY EXACT LOCATION PRIOR TO ROUGH-IN.
- (P15) DOORBELL, REFER TO KEY NOTE 1.
- (P16) DOORBELL TRANSFORMER, REFER TO KEY NOTE 1.
- (P17) VISUAL DOORBELL STROBE, REFER TO KEY NOTE 1.
- (P18) SMOKE DETECTOR WITH VISUAL SIGNAL, REFER TO KEY NOTE 1.
- (P19) CARBON MONOXIDE DETECTOR WITH VISUAL SIGNAL, REFER TO KEY NOTE 1.
- (P20) TWO-WAY COMMUNICATION SYSTEM BDA/DAS CABINET ADD BATTERY CABINET, EXACT LOCATION AND REQUIREMENTS TO BE VERIFIED, REFER TO GENERAL NOTE-C THIS SHEET.
- (P21) ELEVATOR: 208V-3# 29.2 FLA, 3 #4 +1 #10GRD-1 1/4", (60A/50AFU/3P C.B.), EA-37,39,41. VERIFY REQUIREMENTS WITH SUBMITTAL. 3 #6 +1 #10GRD-1" C.
- (P22) ELEVATOR CAB LIGHT, 120V-1#, GFI, (20A-1P C.B.), EA-17
- (P23) ELEVATOR CAB A/C, 120V-1#, GFI, (20A-1P C.B.), EA-19
- (HHP1-), (HHP2-), (HHP3-), (HHP961-), (HHP96

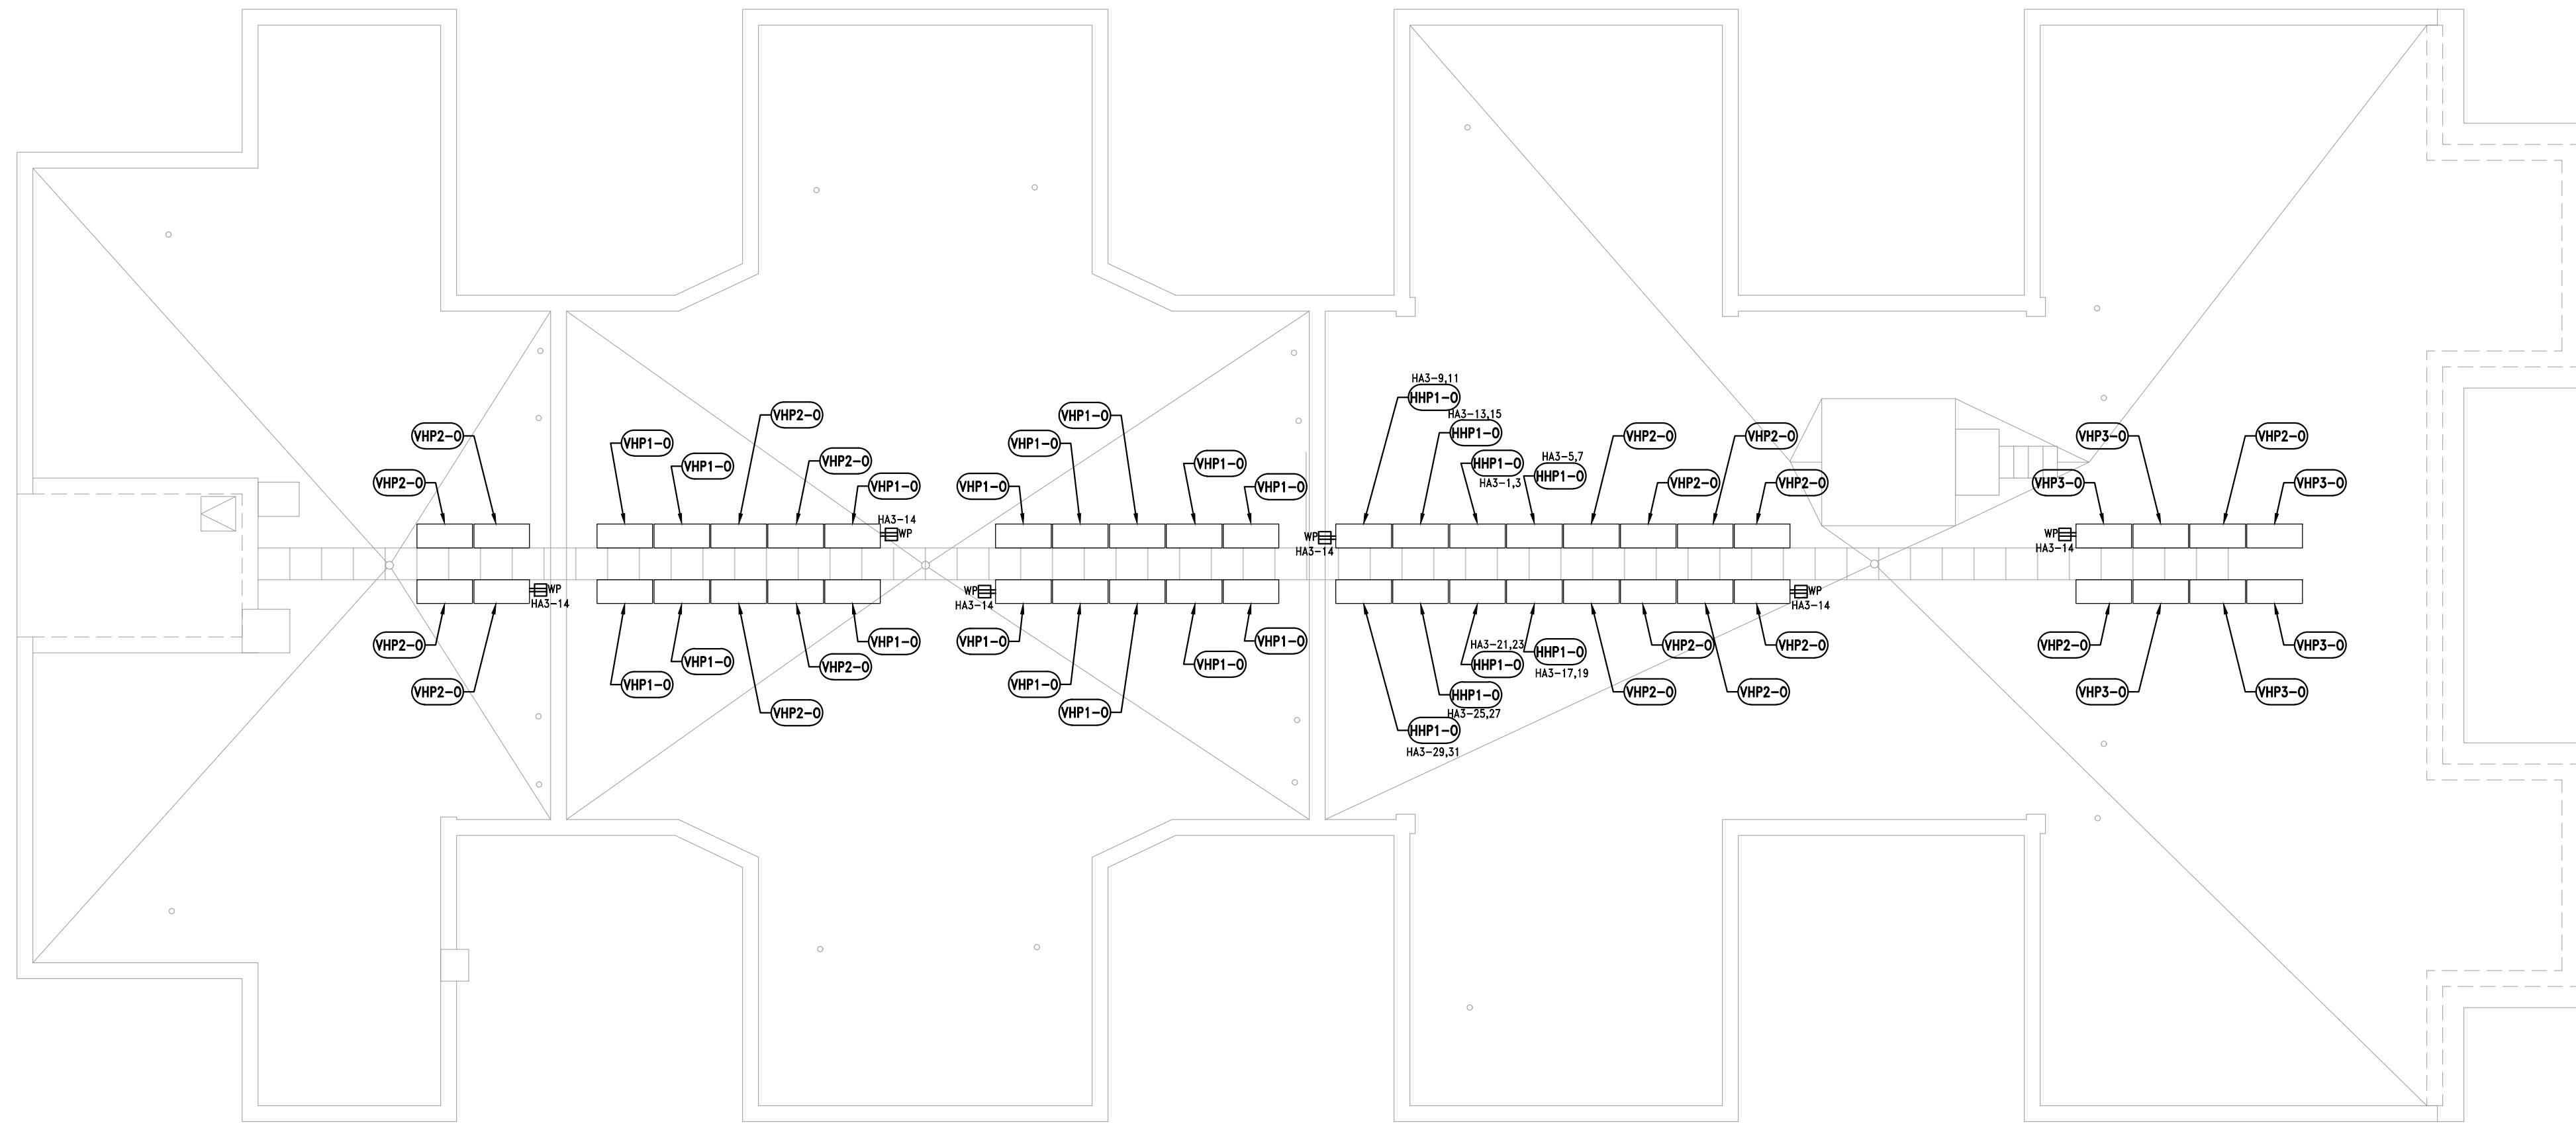

1
E2.5
Roof Plan - Power
Scale: 1/8" = 1'-0"
North

GENERAL POWER NOTES:
 A. REFER TO SHEET E0.1 FOR ELECTRICAL LEGEND AND GENERAL NOTES.
 B. REFER TO SHEET E0.3 FOR ELECTRICAL RISER DIAGRAM.
 C. REFER TO SHEET E0.4 FOR PANELBOARD SCHEDULES.
 D. COORDINATE EXACT LOCATIONS AND REQUIREMENTS WITH MECHANICAL DRAWINGS AND MANUFACTURER SPECIFICATIONS.


MECHANICAL EQUIPMENT WIRING SCHEDULES							
-COORDINATE WITH MECHANICAL DRAWINGS-							
SPLIT HEAT PUMPS							
TAG	ELECTRICAL DATA				NOTES	FED FROM	FEEDER SIZE
	VOLT	Ø	MOCB	MCA			
HHP-1-1/HHP-1-0	208	1	20	18.3	30/20/2 DISC.	HOUSE AND TENANT PANELS	20Y
HHP-2-1/HHP-2-0	208	1	30	20.8	30/30/2 DISC.	NONE ON PLANS	30Y
HHP-3-1/HHP-3-0	208	1	30	20.8	30/30/2 DISC.	HOUSE AND TENANT PANELS	30Y
VHP-1-1/VHP-1-0	208	1	35	31.9	60/35/2 DISC.	HOUSE AND TENANT PANELS	35Y
VHP-2-1/VHP-2-0	208	1	40	38.7	60/40/2 DISC.	HOUSE AND TENANT PANELS	40Y
VHP-3-1/VHP-3-0	208	1	45	42.4	60/45/2 DISC.	HOUSE AND TENANT PANELS	50Y
EXHAUST FANS							
TAG	AREA SERVED	MOTOR			NOTES	FED FROM	FEEDER SIZE
		HP(W)	VOLT	Ø			
EF-1	BATHROOMS	(80)	120	1	LIGHT SWITCH BY E.T.	TENANT PANEL	20Y
EF-2	FIRE RISER ROOM	1/4	120	1	HOA STARTER	HB-20	20Y
EF-3	BASEMENT TOILETS	(80)	120	1	LIGHT SWITCH BY E.T.	GB-2	20Y
ELECTRIC HEATERS							
TAG	AREA SERVED	MOTOR			NOTES	FED FROM	FEEDER SIZE
		HP(W)	VOLT	Ø			
EH-1	CORR TOO GATE ENTRY 114, STAIR 109	1.5	120	1	DISC. BY M.F.	SEE PLAN	20Y
EH-2	STAIR 112	4.0	208	3	DISC. BY M.F.	SEE PLAN	20X
EUH-1	BASEMENT	3.3	208	3	DISC. BY M.F.	SEE PLAN	20X
EUH-2	BASEMENT	5.0	208	3	DISC. BY M.F.	SEE PLAN	20X
EUH-3	BASEMENT	7.5	208	3	DISC. BY M.F.	SEE PLAN	20X
WATER HEATERS							
TAG	LOCATION	MOTOR			NOTES	FED FROM	FEEDER SIZE
		AMPS	VOLT	Ø			
DWH-1	WATER HEATER 018	5.0	120	1	PLUG & CORD	HC-2	20Y
DWH-2	WATER HEATER 018	5.0	120	1	PLUG & CORD	HC-4	20Y
DWH-3	WATER HEATER 018	5.0	120	1	PLUG & CORD	HC-6	20Y
DOMESTIC WATER BOOSTER PUMP							
TAG	LOCATION	MOTOR			NOTES	FED FROM	FEEDER SIZE
		AMPS	VOLT	Ø			
DWBP-1	ELEC RM	21.2	208	3	60/35/3 DISC.	HA-13	35X
SUMP PUMP							
TAG	LOCATION	MOTOR			NOTES	FED FROM	FEEDER SIZE
		AMPS	VOLT	Ø			
SP-1	ELEVATOR	15	120	1	30/2 DISC.	EA-4	20Y
SP-2	ELEC RM	6.4	208	3	30/3 DISC.	DP-HA	20X
RECIRCULATION PUMP							
TAG	LOCATION	MOTOR			NOTES	FED FROM	FEEDER SIZE
		HP	VOLT	Ø			
CP-1	STORAGE 015	1/6	120	1	-	HC-35	20Y
DOAS-1							
TAG	ELECTRICAL DATA				NOTES	FED FROM	FEEDER SIZE
	VOLT	Ø	MOCB	MCA			
DOAS-1	208	3	35A	31.5	60/35/3 DISC.	HC-16,18,20	35X



104 W. Fourth Street
 Suite 303
 Royal Oak, Michigan 48067
 248.629.7153 ph.
 248.629.7154 fax

www.SHELTERSTUDIO.LLC

Architect of Record

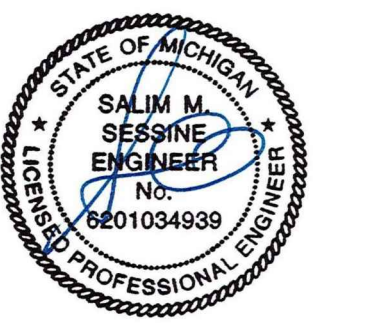


EAM Engineers, Inc.
 Electrical and Mechanical Consulting Engineers
 180 High Oak Road, Bloomfield Hills, MI 48304
 Phone 248.528.6770 Fax 248.528.1642
 www.eam-engineers.com eam@eam-engineers.com
 Job No. 483-21061

Owner

DEVELOP DETROIT
 1452 Randolph Street, Suite 300
 Detroit, MI 48226

Project

**Apartment Renovation
 LINWOOD APARTMENTS**
 2295 W Grand Blvd
 Detroit, MI 48208

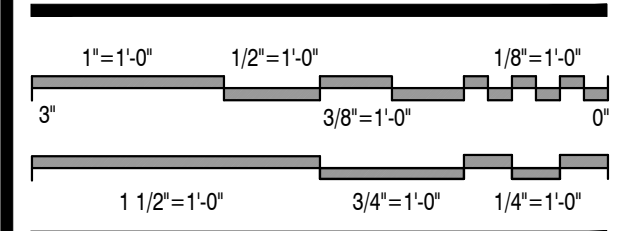


Issued For	Date
Preliminary Review	01.31.2023
Review & Bids	02.27.2023
Bids & Permits	08.12.2024
Plan Review Revisions	03.20.2025
MSHDA Revisions	05.07.2026

Drawing Title
**Roof Plan
 - Power**


2021-248
 Project No.
 JLW Drawn By
 EK Checked By
 As Noted
 Scale

E2.5
 Drawing No.


H:\EAM-MAIN\Projects\2021\483 Shelter Design\21061 Linwood Apartments Design\21061 Floor Plans - Power.dwg, 6/2/2026 11:56:10 AM, jwatson

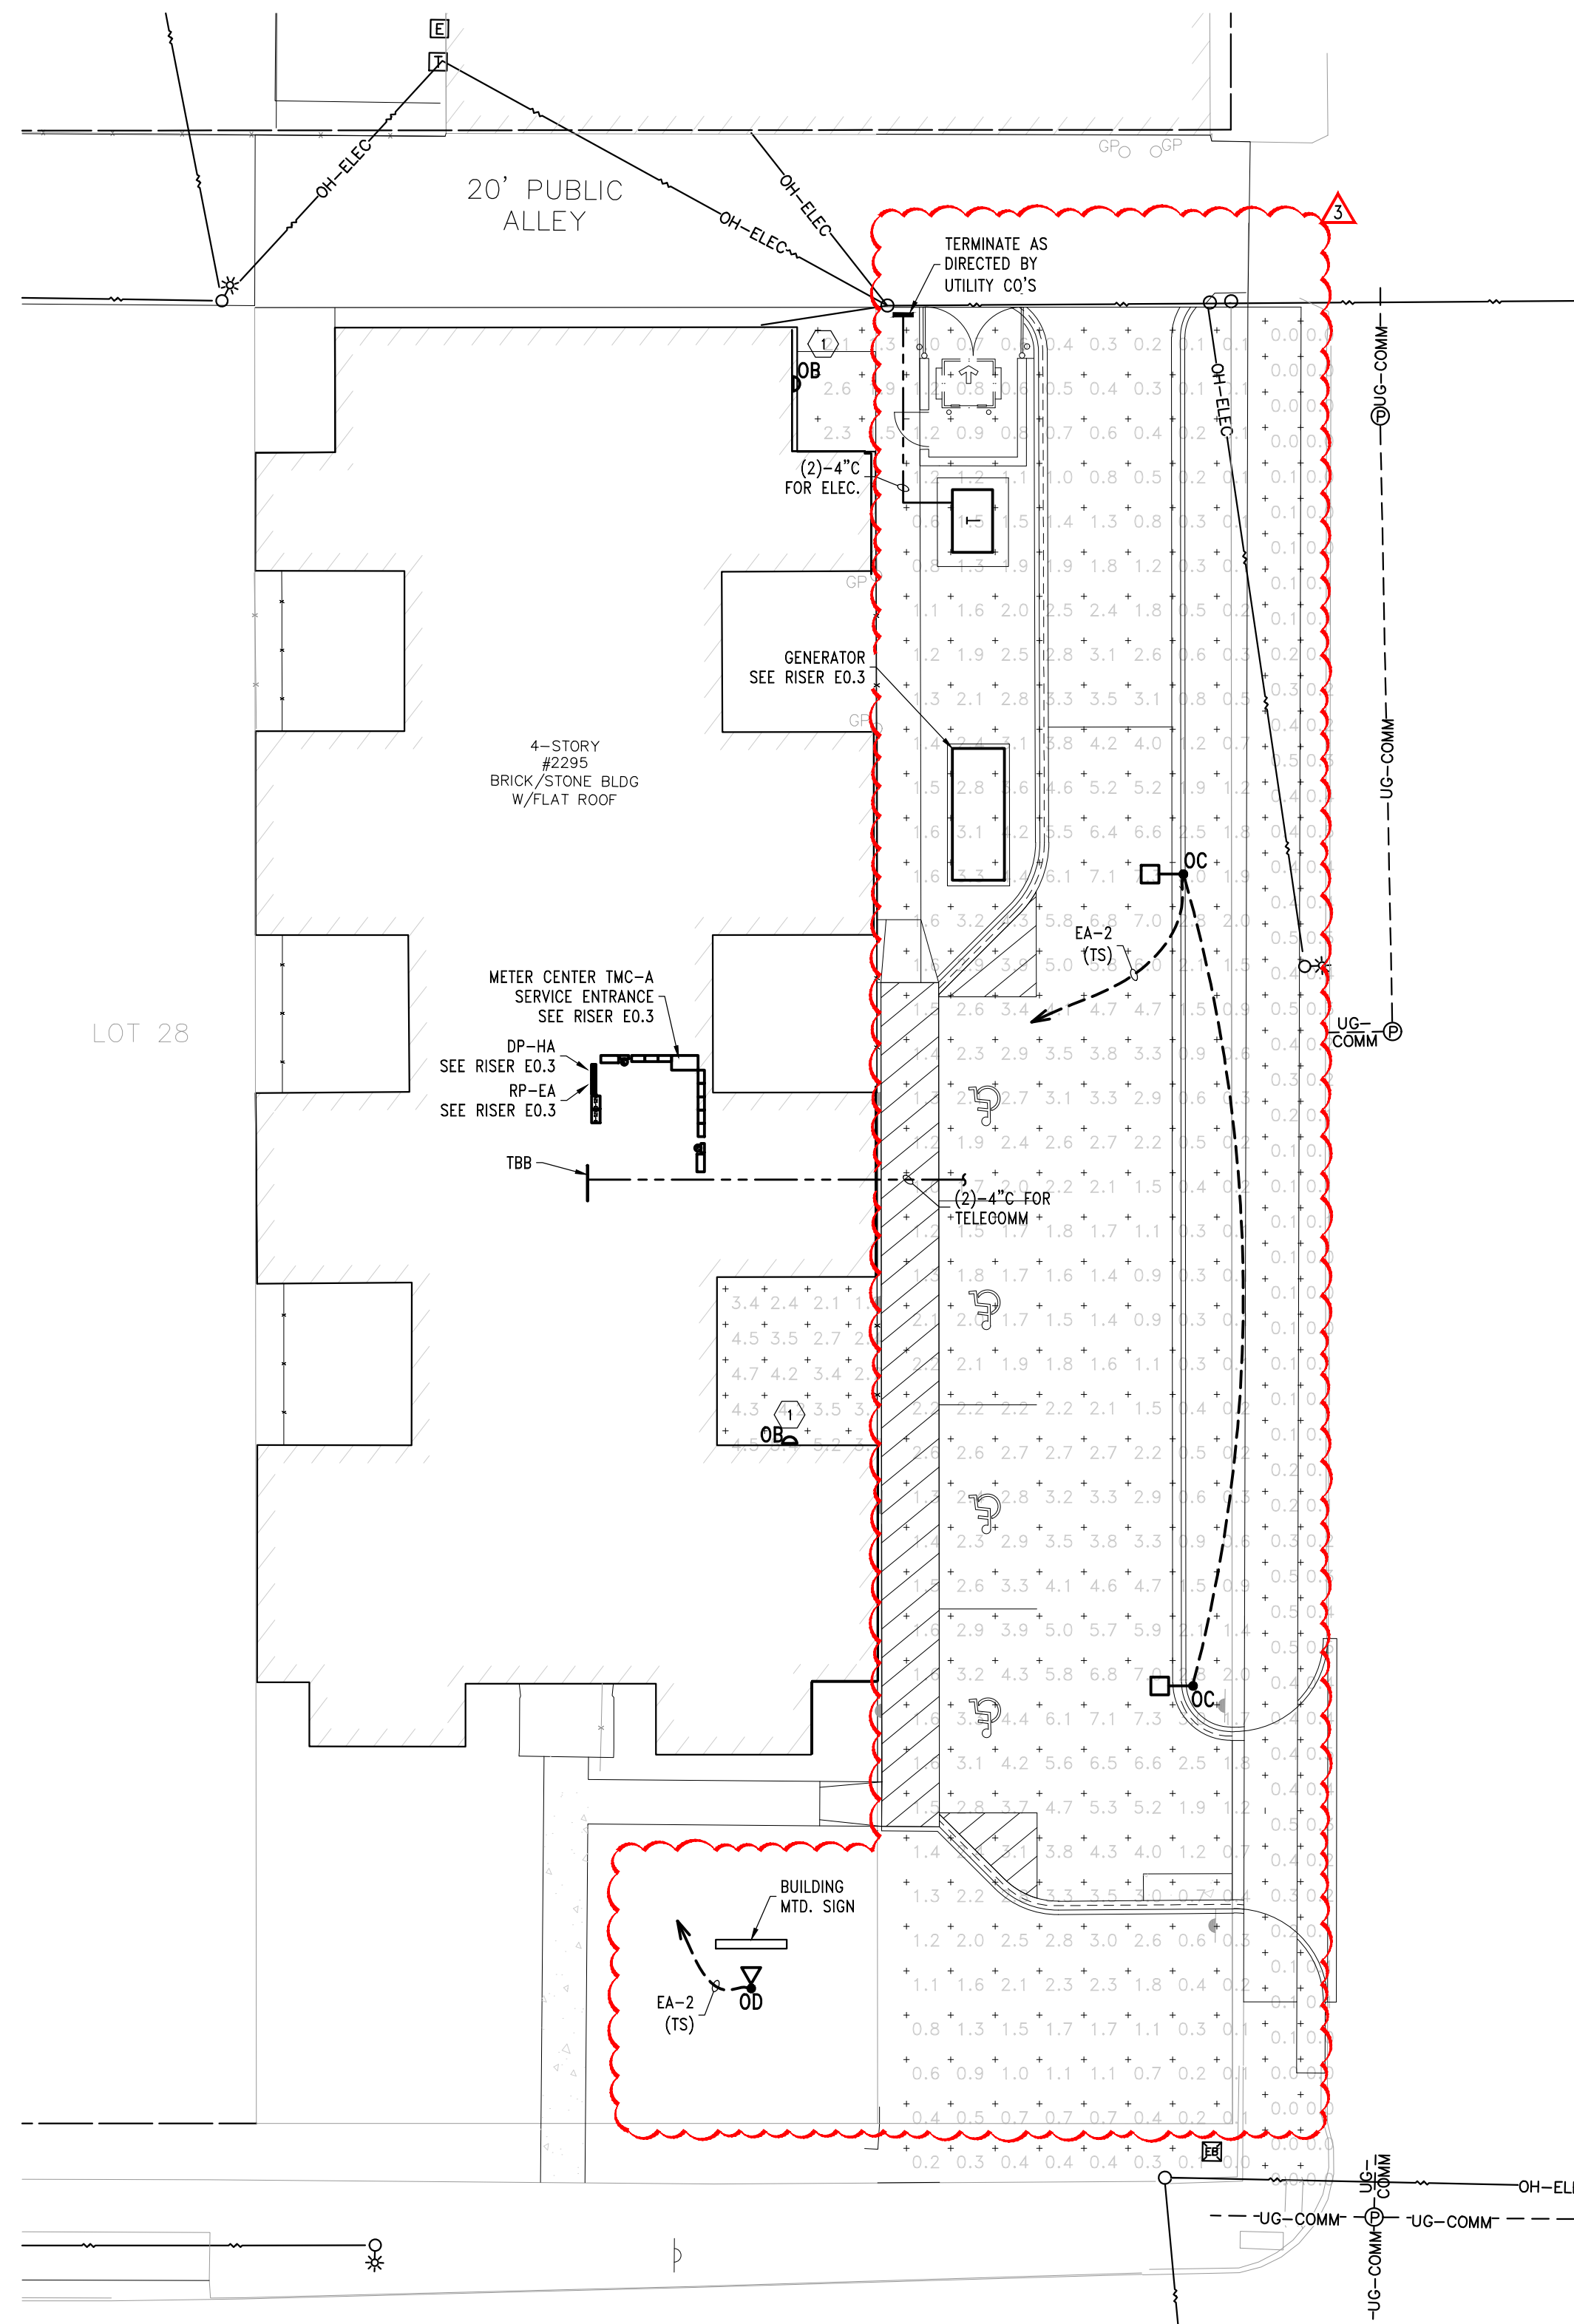

1 Electrical Site Plan
E0.5 Scale: 1/16" = 1'-0"

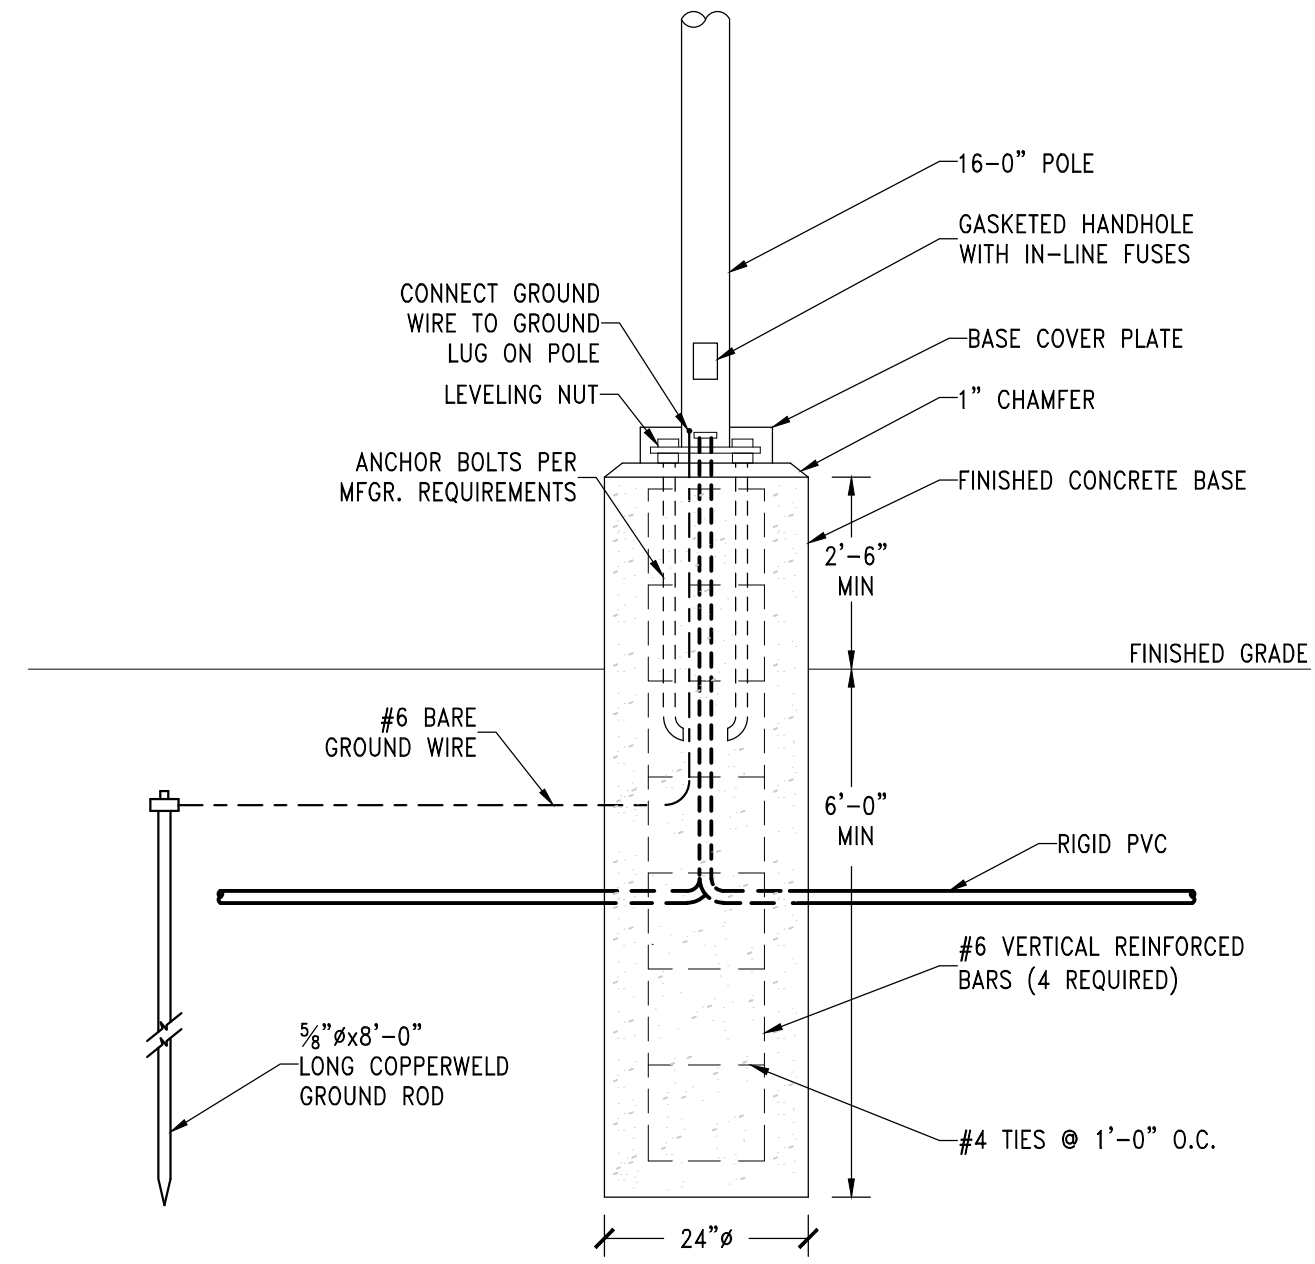

CONCRETE BASE DETAIL (OC)
NO SCALE

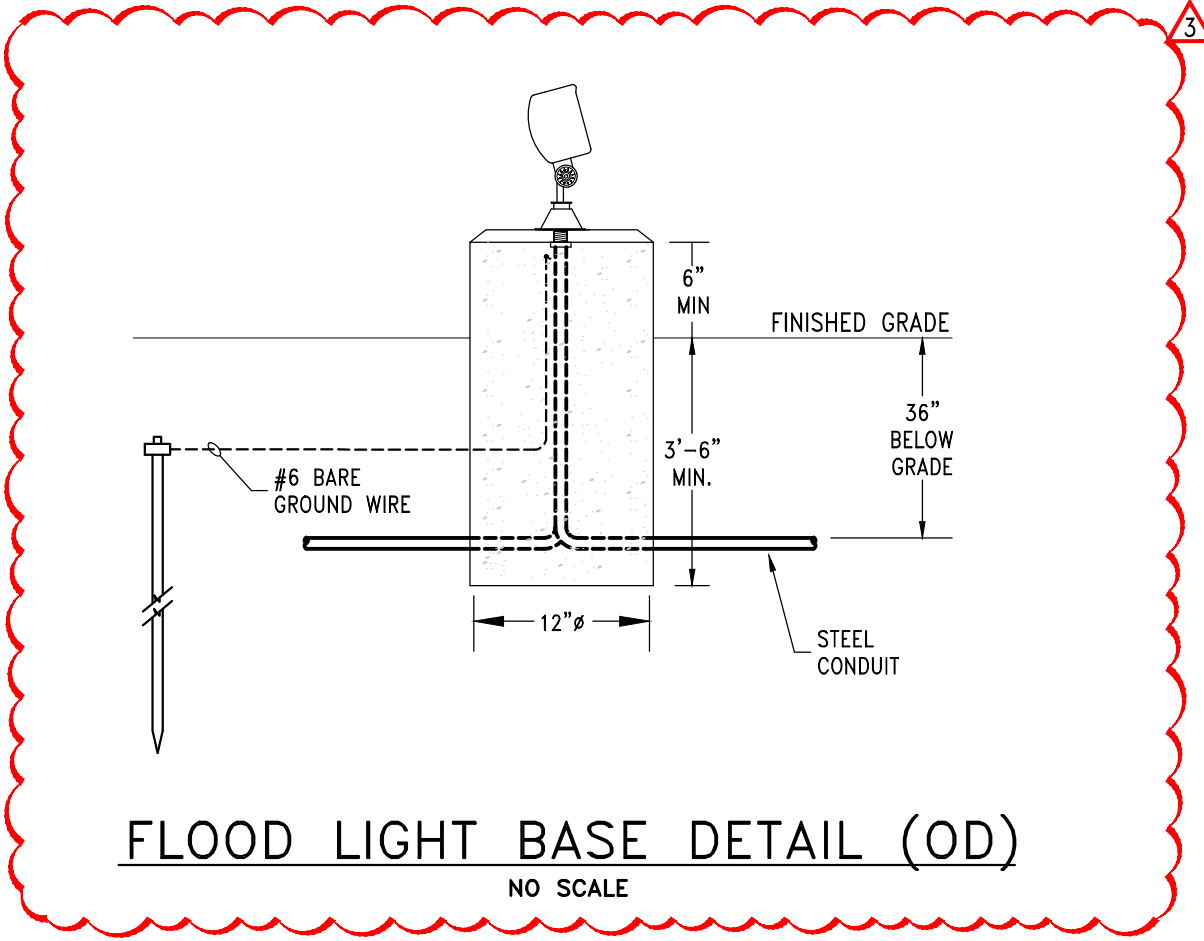

FLOOD LIGHT BASE DETAIL (OD)
NO SCALE

SITE PLAN NOTES:

1. THIS CONTRACTOR SHALL INCLUDE IN HIS BID PRICE ALL COSTS ASSESSED BY THE UTILITY COMPANIES FOR THE NEW ELECTRICAL AND TELEPHONE SERVICE.
2. COORDINATE ALL NEW MECHANICAL AND ELECTRICAL UNDERGROUND WORK WITH NEW AND EXISTING UNDERGROUND UTILITIES BEFORE INSTALLATION.
3. PRIOR TO ANY EXCAVATION, THE CONTRACTOR SHALL CONTACT "811" FOR THE LOCATION OF UNDERGROUND UTILITIES AND SHALL NOTIFY REPRESENTATIVE OF OTHER UTILITIES LOCATED IN THE VICINITY OF THE WORK. EXTRAS WILL NOT BE ALLOWED SHOULD THE CONTRACTOR DISREGARD THIS VERIFICATION.
4. CONTRACTOR SHALL FIELD VERIFY EXACT SERVICE POINTS WITH THE UTILITY COMPANY PRIOR TO SUBMITTING HIS BID PRICE.
5. UNDERGROUND SERVICE CONDUITS SHALL BE DIRECT BURIED PLASTIC CONDUIT, CARLON TYPE 40 OR EQUAL, MINIMUM COVER REQUIREMENTS 24" BELOW GRADE.
6. REFER TO CIVIL SITE PLAN DRAWING FOR ADDITIONAL INFORMATION.

KEYED NOTES:

- 1 REFER TO SHEET E2.1 FOR BUILDING MOUNTED LIGHTING CIRCUITS.
- 2 REFER TO SHEET E0.2 FOR COMPLETE LIGHTING FIXTURE SCHEDULES.



Know what's below.
Call before you dig.

UTILITY INFORMATION, AS SHOWN, INDICATES APPROXIMATE LOCATIONS AND TYPES OF FACILITIES ONLY, AS DISCLOSED TO THIS FIRM BY THE VARIOUS UTILITY COMPANIES' RECORDS. NO GUARANTEE IS GIVEN OR IMPLIED AS TO THE COMPLETENESS OR ACCURACY THEREOF.
PRIOR TO CONSTRUCTION, ALL LOCATION AND DEPTHS OF EXISTING OVERHEAD AND UNDERGROUND UTILITIES IN CONFLICT WITH THE CONSTRUCTION OF PROPOSED IMPROVEMENTS SHALL BE VERIFIED IN THE FIELD.
DURING CONSTRUCTION, CONTRACTOR SHALL USE EXTREME CAUTION WHEN OPERATING NEAR OVERHEAD AND/OR BURIED UTILITIES.



104 W. Fourth Street
Suite 303
Royal Oak, Michigan 48067
248.629.7153 ph.
248.629.7154 fax

www.SHELTERSTUDIO.LLC.com

Architect of Record




EAM Engineers, Inc.
Electrical and Mechanical Consulting Engineers
180 High Oak Road, Bloomfield Hills, MI 48304
Phone 248.528.6570 Fax 248.528.1642
www.eam-engineers.com eam@eam-engineers.com
Job No. 483-21061

Owner

DEVELOP DETROIT
1452 Randolph Street, Suite 300
Detroit, MI 48226

Project

**Apartment Renovation
LINWOOD APARTMENTS**
2295 W Grand Blvd
Detroit, MI 48208

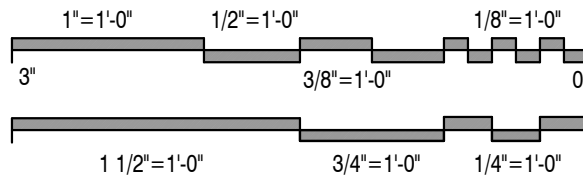

Issued For	Date
Preliminary Review	01.31.2023
Review & Bids	02.27.2023
Bids & Permits	08.12.2024
Plan Review Revisions	03.20.2025
MSHDA Revisions	05.07.2026

Symbol	Label	Quantity	Catalog Number	Manufacturer	Description	Number Lamps	Lumens Per Lamp	Light Loss Factor	Wattage
OB	OB	3	WSR LED P1 SR4 40K MVOLT	Lithonia Lighting	WSR LED WITH P1-PERFORMANCE PACKAGE, 4000K, AND SR4 OPTIC TYPE	1	2190	0.9	19.56
OC	OC	2	RSX1 LED P4 50K R4 HS	Lithonia Lighting	RSX LED Area Luminaire Size 1 P4 Lumen Package 5000K CCT Type R4 Distribution with HS shield	1	10893	0.9	133.14

Description	Symbol	Max	Min	Max/Min	Avg/Min	Avg
Behind Parking	+	0.5 fc	0.0 fc	N/A	N/A	0.2 fc
Side Entry	+	5.4 fc	1.9 fc	2.8:1	1.9:1	3.6 fc
West Parking	+	7.3 fc	0.0 fc	N/A	N/A	2.1 fc

Drawing Title
Electrical Site Plan

2021-248
Project No.
JLW EK
Drawn By Checked By
As Noted
Scale

E3.0
Drawing No.